

MISSISSIPPI DEPARTMENT OF NATURAL RESOURCES
Bureau of Land and Water Resources
 Southport Mall
 P.O. Box 10631
 Jackson, Mississippi 39209
WATER WELL DRILLERS LOG

Perry
 9 2011

June 2 1982 *Cochean Bro. Drilling Svc* *PERRY*
 date well completed firm name county well located

LANDOWNER: *L Van Lowe*
Rt 1
Beaumont
 (mailing address)

WELL LOCATION:
 sec. *27* T. *30* S. R. *9* E. *(W)*
5 miles *NE* of *Beaumont*
 (distance) (direction) (nearest town)

WELL PURPOSE: *Home*
 (Home, Irrigation, municipal, industrial)

WELL COMPLETION DATA:

- (1) diameter (inches) *2"*
- (2) total depth (feet) *490'*
- (3) static water level (feet) *below* top of ground.
- (4) casing *PVC*, *480'*
 (material) (depth)
 (size) If telescope see back.
- (5) screen *10'*, *480'*
 (length) (depth to top)
2", *PVC*
 (size) (material)
- (6) pump *—*, *42*
 (HP) (yield gpm)
 (type power) *—*
- (7) electric log (yes or no) *—*
 (organization running log) *—*
- (8) how well bottom plugged *valve*

description of formations encountered	from	to
<i>TOP Soil</i>	<i>0</i>	<i>1</i>
<i>Red clay</i>	<i>1</i>	<i>8</i>
<i>Red sand</i>	<i>8</i>	<i>15</i>
<i>Sand & Gravel</i>	<i>15</i>	<i>38</i>
<i>DRAY CLAY</i>	<i>38</i>	<i>51</i>
<i>Blue clay</i>	<i>51</i>	<i>110</i>
<i>Sand</i>	<i>110</i>	<i>140</i>
<i>blue clay</i>	<i>140</i>	<i>260</i>
<i>Shale</i>	<i>260</i>	<i>285</i>
<i>blue clay</i>	<i>285</i>	<i>310</i>
<i>sand</i>	<i>310</i>	<i>340</i>
<i>blue clay</i>	<i>340</i>	<i>415</i>
<i>Sand</i>	<i>415</i>	<i>490</i>

DEPT. OF NATURAL RESOURCES
 BUREAU OF LAND & WATER RESOURCES


OCT 4 1982

RECEIVED

DRILLERS REMARKS: *—*

If well telescopes please sketch and show depths.

GROUND LEVEL

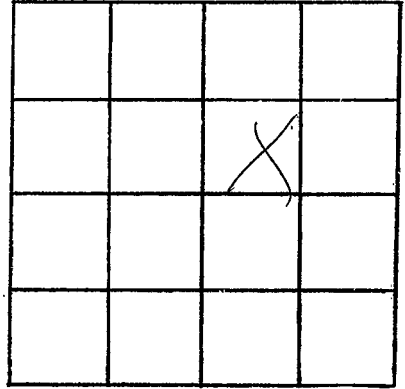

SECTION 27

Please indicate well location X.

ADDITIONAL INFORMATION

If more than one screen, show locations of each on sketch.