

**MISSISSIPPI DEPARTMENT OF NATURAL RESOURCES**  
**Bureau of Land and Water Resources**  
 Southport Mall  
 P.O. Box 10631  
 Jackson, Mississippi 39209  
**WATER WELL DRILLERS LOG**

*Perry*  
 of 2012

July 20 - 1982 date well completed      Cochran Bore Drilling Service firm name      Perry county well located

**LANDOWNER:**  
 Orin Carrahan  
 Rt 1 Beaumont  
 (mailing address)

| description of formations encountered | depth |    |
|---------------------------------------|-------|----|
|                                       | from  | to |
| TOP Soil                              | 0     | 2  |
| Sandy clay                            | 2     | 6  |
| sand + Gravel                         | 6     | 45 |

**WELL LOCATION:**  
 sec 20 T 3 N R 9 E  
 (distance) miles (direction) of (nearest town)  
 1 miles S of Kirtland

**WELL PURPOSE:** None  
 (home) Irrigation, municipal, industrial

- WELL COMPLETION DATA:**
- (1) diameter (inches) 2"
  - (2) total depth (feet) 45'
  - (3) static water level (feet) 12 below above top of ground.
  - (4) casing PVC, 40'  
 (material) (depth)  
 (size) If telescope see back.
  - (5) screen 5' 40'  
 (length) (depth to top)  
2 PVC  
 (size) (material)
  - (6) pump 1 9  
 (HP) (yield gpm)  
Elec  
 (type power)
  - (7) electric log (yes or no) \_\_\_\_\_  
 (organization running log) \_\_\_\_\_
  - (8) how well bottom plugged None

**DRILLERS REMARKS:**


MISSISSIPPI DEPARTMENT OF NATURAL RESOURCES  
 BUREAU OF LAND & WATER RESOURCES

OCT - 4 1982

**RECEIVED**

If well telescopes please sketch and show depths.

GROUND LEVEL

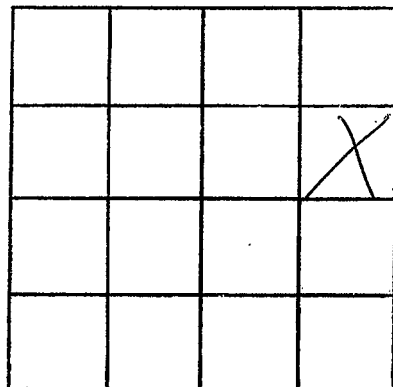

SECTION 20

Please indicate well location X.

ADDITIONAL INFORMATION

If more than one screen,  
show locations of each on sketch.