

Perry
 J 2013

MISSISSIPPI
 BOARD OF WATER COMMISSIONERS
 416 North State Street
 Jackson, Mississippi 39201

WATER WELL DRILLERS LOG

Jan. 20 1982 C.P. Clark Wtr. Wells Perry
 date well completed firm name county well located

LANDOWNER: Zumbelt
Form and Tree
Hattiesburg, Miss.
 (mailing address)

WELL LOCATION:
 sec. 6 T. 3 N R. 9 W
5 miles N of Beaumont
 (distance) (direction) (nearest town)

WELL PURPOSE:
 (home, irrigation, municipal, industrial)

WELL COMPLETION DATA:
 (1) diameter (inches) 2
 (2) total depth (feet) 100
 (3) static water level (feet) 116 below top of ground.
 (4) casing galv. 155'
 (material) (depth)
 (size) if telescope see back.
 (5) screen 5 155'
 (length) (depth to top)
2" Stainless Steel
 (size) (material) (.007)
 (6) pump 2 5 1/2
 (HP) (yield gpm)
220V 1φ
 (type power)
 (7) electric log no
 (yes or no)
 (organization running log)
 (8) how well bottom plugged BUW

description of formations encountered	from	to
Gravel & top soil	0	1
tan clay	1	4
Red clay	4	21
sand and gravel	21	90
clay w/ sandy str	90	104
Gravel	104	112
Sandy clay / gravel	112	131
tan clay / sandy	131	142
Gravel & clay mixed	142	151
Gravel w/ thick clay	151	162
sandy clay w/ rd str	162	170

DEPT. OF NATURAL RESOURCES
 BUREAU OF LAND & WATER RESOURCES


FEB - 2 1982

RECEIVED

DRILLERS REMARKS:

If well telescopes please sketch and show depths.

GROUND LEVEL

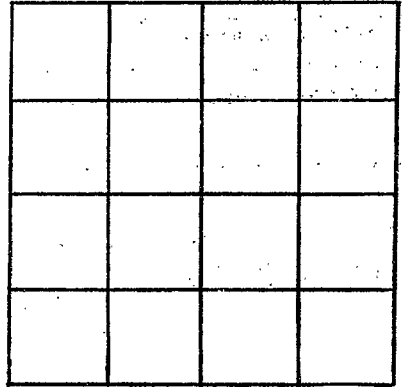

SECTION _____

Please indicate well location X.

ADDITIONAL INFORMATION

If more than one screen,
show locations of each on sketch.