

MISSISSIPPI DEPARTMENT OF NATURAL RESOURCES
Bureau of Land and Water Resources
 Southport Mall
 P.O. Box 10631
 Jackson, Mississippi 39209
WATER WELL DRILLERS LOG

Perry
8 2014

Aug 30 1983 Cochran Water Well Perry
 date well completed firm name county well located

LANDOWNER:	description of formations encountered	from	to
<u>Betties Roberts</u>	<u>Top Soil</u>	<u>0</u>	<u>1</u>
<u>Rt 1 Richton</u> (mailing address)	<u>red clay</u>	<u>1</u>	<u>4</u>
	<u>red sand</u>	<u>4</u>	<u>8</u>
	<u>gray clay</u>	<u>8</u>	<u>12</u>
	<u>sand</u>	<u>12</u>	<u>35</u>
WELL LOCATION:			
sec. <u>5</u> T. <u>3</u> (N) R. <u>9</u> E S W			
<u>3</u> miles <u>S</u> of <u>Holtsville</u> (distance) (direction) (nearest town)			
WELL PURPOSE:			
(home, irrigation, municipal, industrial)			
WELL COMPLETION DATA:			
(1) diameter (inches) <u>2"</u>			
(2) total depth (feet) <u>35'</u>			
(3) static water level (feet) <u>6</u> <u>below</u> above top of ground.			
(4) casing <u>PVC</u> <u>30'</u> (material) (depth)			
_____ If telescope see back. (size)			
(5) screen <u>5'</u> <u>30'</u> (length) (depth to top)			
<u>2</u> <u>PVC</u> (size) (material)			
(6) pump <u>1</u> <u>8</u> (HP) (yield gpm)			
<u>Elc</u> (type power)			
(7) electric log <u>no</u> (yes or no)			
_____ (organization running log)			
(8) how well bottom plugged <u>valve</u>			

DEPT. OF NATURAL RESOURCES
 BUREAU OF LAND & WATER RESOURCES


SEP 13 1983

RECEIVED

DRILLERS REMARKS:

If well telescopes please sketch and show depths.

GROUND LEVEL

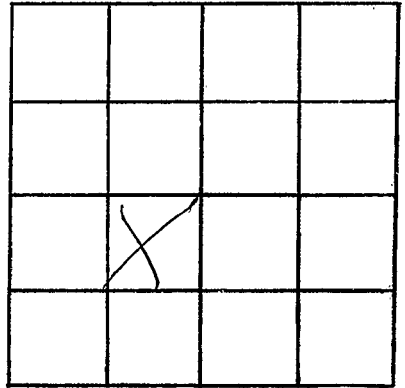

SECTION 5

Please indicate well location X.

ADDITIONAL INFORMATION

If more than one screen,
show locations of each on sketch.