

MISSISSIPPI DEPARTMENT OF NATURAL RESOURCES

Bureau of Land and Water Resources

Southport Mall

P.O. Box 10631

Jackson, Mississippi 39209

WATER WELL DRILLERS LOG

Perry  
2015

10-13 1983  
date well completed

Judy's Well Service  
firm name

Perry  
county well located

LANDOWNER: PAUL Byrd

BOX 123

BEAUMONT, ms. 39423  
(mailing address)

description of formations encountered

Topsoil - SAND - GRAVE  
CLAY - Couple small  
strips of SAND  
SAND

from

to

0 35'  
35 190  
190 225'

WELL LOCATION:

sec. 26 T. 3 N R. 9 E  
3 miles North of Beaumont  
(distance) (direction) (nearest town)

WELL PURPOSE:

(home, irrigation, municipal, industrial)

WELL COMPLETION DATA:

- (1) diameter (inches) 2"
- (2) total depth (feet) 225
- (3) static water level (feet) 8 below top of ground.
- (4) casing PVC, 225, (material) (depth)

if telescope see back.  
(size)

- (5) screen 10' (length), (depth to top)  
#6, PVC (size) (material)

- (6) pump 1/2 (HP), 6 (yield gpm)  
(type power)

- (7) electric log no (yes or no)

(organization running log)

- (8) how well bottom plugged

DRILLERS REMARKS:


DEPT. OF NATURAL RESOURCES  
BUREAU OF LAND & WATER RESOURCES

OCT 31 1983

RECEIVED

If well telescopes please sketch and show depths.

GROUND LEVEL

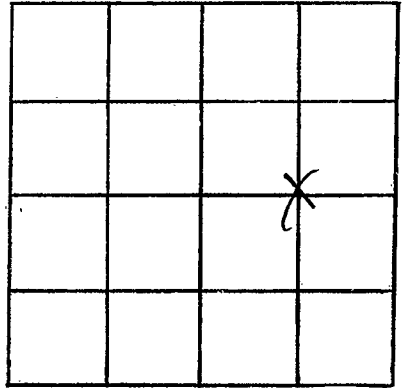

SECTION 4

Please indicate well location X.

ADDITIONAL INFORMATION

If more than one screen,  
show locations of each on sketch.