

MISSISSIPPI DEPARTMENT OF NATURAL RESOURCES

Bureau of Land and Water Resources

Southport Mall

P.O. Box 10631

Jackson, Mississippi 39209

WATER WELL DRILLERS LOG

PERRY  
J 2016

June 18 1985 Cochran Water Well Service Perry  
date well completed firm name county well located

LANDOWNER:  
Robert Farms  
Rt 2 Beaumont  
(mailing address)

description of formations encountered	from	to
TOP SOIL	0	2
red, gray	2	5
red sand	5	12
Sand + gravel	12	30

WELL LOCATION:  
sec 5 T 3 N R 9 E  
S W  
2 miles S of Hixsonville  
(distance) (direction) (nearest town)

WELL PURPOSE:  
(home/irrigation, municipal, industrial)

- WELL COMPLETION DATA:
- (1) diameter (inches) 2"
  - (2) total depth (feet) 30'
  - (3) static water level (feet) 6 below above top of ground.
  - (4) casing PVC, 25'  
(material) (depth)  
2"  
(size) if telescope see back.
  - (5) screen 5', 25'  
(length) (depth to top)  
2" PVC  
(size) (material)
  - (6) pump 1/4  
(HP) (yield gpm)  
(type power)
  - (7) electric log \_\_\_\_\_  
(yes or no)  
(organization running log)
  - (8) how well bottom plugged valve


RECEIVED  
AUG 20 1985

DRILLERS REMARKS:

Department of Natural Resources  
Bureau of Land & Water Resources

If well telescopes please sketch and show depths.

GROUND LEVEL

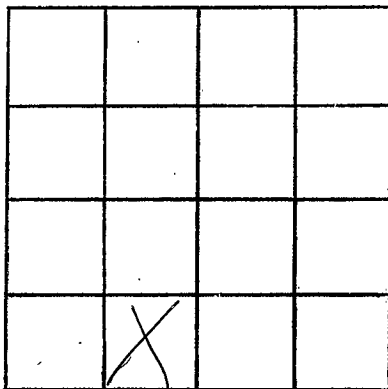

SECTION 5

Please indicate well location X.

ADDITIONAL INFORMATION

If more than one screen  
show locations of each on sketch.