

MISSISSIPPI DEPARTMENT OF ENVIRONMENTAL QUALITY
Bureau of Land and Water Resources

P. O. Box 10631
Jackson, MS 39289-0631
WATER WELL DRILLERS LOG

COUNTY: WELL LOCATED	
<i>Perry</i>	
WELL NUMBER	CODED
<i>5 2021</i>	
DATE WELL COMPLETED	
<i>8-14-92</i>	

PERMIT NUMBER
<i>020 0408</i>
NAME OF DRILLING FIRM
<i>Fry Fog Lawless</i>
<i>Box 303</i>
<i>Sumner MS 39452</i>

NAME & MAILING ADDRESS OF LANDOWNER		
<i>Edd Rodgers</i>		
<i>Western Auto Store</i>		
<i>P.O. Box 67</i>		
<i>McLean MS 39456</i>		
WELL LOCATION: SEC	TOWNSHIP	RANGE
<i>Bywater 7</i>	<i>T3</i>	<i>S 09 E</i>
DISTANCE	DIRECTION	NEAREST TOWN
<i>5</i> Miles	<i>north</i>	<i>Reservoir</i>
OTHER LANDMARK		
<i>across from Mitchell Church</i>		
WELL PURPOSE: Home, Irrigation, Municipal, Industrial, Fish Pond, etc.		
<i>Comp.</i>		

PUMP DATA		
PUMP TYPE (Circle One):		
Submersible,	Turbine,	<input checked="" type="radio"/> Jet
Other (Describe)		Flowing Well,
POWER TYPE (Circle One):		
<input checked="" type="radio"/> Electric	Tractor,	Diesel, Gasoline, Butane,
Other (Describe)		H/P <i>1</i>
Pump Capacity (GPM)	No. of Stages	Setting Depth
<i>10</i>	<i>1</i>	<i>30'</i> FT.
PUMP TEST		
Well yielded <i>15</i> GPM with		
a drawdown of <i>0</i> ft.		
after <i>1 1/2</i> hours of pumping		

Well Depth	Casing Diameter (In.)	Casing Length (Ft.)
<i>75'</i>	<i>2"</i>	<i>70'</i>
Type of Casing	Hole Depth	Depth to Static Water Level
<i>PVC</i>	<i>75</i>	<i>20'</i>
TYPE OF COMPLETION: (Circle One or More):		
Gravel Packed, Underreamed, Telescoped,		
Natural Development, Open Hole, Other		
(Describe) <i>air lift</i>		
Top of Lap Pipe or Reduction in Casing		
FEET		
IF TELESCOPED OR MORE THAN ONE SCREEN: USE BACK PAGE		

LOG DATA	
TYPE OF LOG RUN (Circle One):	
No Log Run, Electric, Gamma Ray, Density, Sonic, Neutron, Other (Describe)	
Name of Organization Running Log	


SCREEN DATA		
Diameter - Inches	Length - Feet	Slot Size - Inches
<i>2"</i>	<i>5'</i>	<i>#8</i>
Screen Type	Depth to Bottom - Feet	
<i>Wrapped Screen</i>	<i>75'</i>	

GEOLOGIC DATA (Office Use Only)			
Surface Elev.	Geologic Unit	Unit Thickness	Depth to Top
Subs. SWL	Date	Analysis	Aquifer Test
Driller's Remarks			

DESCRIPTION OF FORMATIONS ENCOUNTERED	FROM	TO	FORMATIONS (Continued)	FROM	TO
<i>top soil</i>	<i>0</i>	<i>5</i>			
<i>clay</i>	<i>5</i>	<i>20</i>			
<i>sand</i>	<i>20</i>	<i>24</i>			
<i>clay</i>	<i>24</i>	<i>60</i>			
<i>sand</i>	<i>60</i>	<i>75</i>			
Dept. of Environmental Quality Bureau of Land & Water Resources					
IF MORE SPACE IS NEEDED, USE BACK					

If well telescopes please sketch and show depths.

GROUND LEVEL

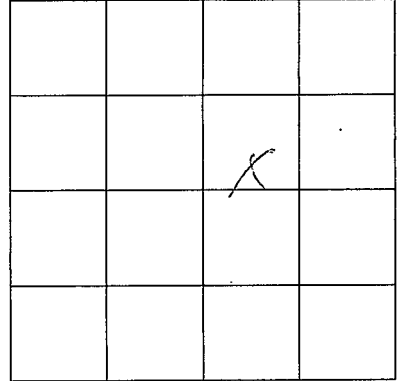

SECTION 7

Please indicate well location X.

ADDITIONAL INFORMATION

If more than one screen,
show location of each on sketch.