

PERRY  
K 2000  
5-2-79

MISSISSIPPI  
BOARD OF WATER COMMISSIONERS  
416 North State Street  
Jackson, Mississippi 39201

WATER WELL DRILLERS LOG

5-2 1979 Parnell Anderson Perry  
date well completed firm name county well located

LANDOWNER: Thomas Wilson	description of formations encountered Top Soil 0 2 Sandy Clay 2 34 Course Sand 34 69	from	to	
(mailing address)				
WELL LOCATION: 36° 30' T 20° 15' R 11° E 8 miles (distance) S 30° W of W. E. A. GUSTIA (nearest town)				
WELL PURPOSE: HOME (home, irrigation, municipal, industrial)				
WELL COMPLETION DATA:				
(1) diameter (inches) 2"				
(2) total depth (feet) 69				
(3) static water level (feet) 34' below top of ground.				
(4) casing Plastic, 64' (material) (depth)				
(size) if telescope see back.				
(5) screen 5' length, 64' depth to top				
2" Plastic (size) (material)				
(6) pump 1 (HP) 8 (yield gpm)				
Elect (type power)				
(7) electric log No (yes or no)				
(organization running log)				
(8) how well bottom plugged: Capped				

DRILLERS REMARKS:


Miss. Board of Water Comm.

JUN - 8 1979

RECEIVED

If well telescopes please sketch and show depths.

GROUND LEVEL

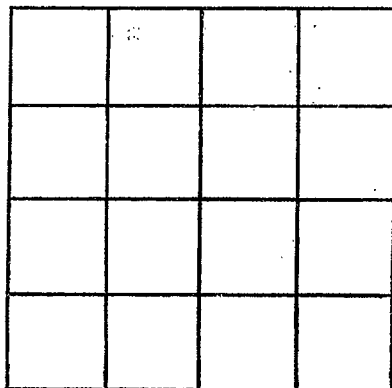

SECTION \_\_\_\_\_

Please indicate well location X.

ADDITIONAL INFORMATION

If more than one screen,  
show locations of each on sketch.