

PERRY
K 200
3-3-79

MISSISSIPPI
BOARD OF WATER COMMISSIONERS
416 North State Street
Jackson, Mississippi 39201

WATER WELL DRILLERS LOG

3-3-79 date well completed 1979 firm name *Paul Anderson* Perry county well located

LANDOWNER:	description of formations encountered	from	to
<i>U S Government</i>	<i>Top Soil</i>	<i>0</i>	<i>2</i>
(mailing address)	<i>Clay</i>	<i>2</i>	<i>82</i>
WELL LOCATION:	<i>Coarse Sand</i>	<i>82</i>	<i>115</i>
sec. <i>36</i> T. <i>2</i> N R. <i>11</i> E S. W.			
<i>8</i> miles <i>S</i> of <i>NEW CANTON</i> (distance) (direction) (nearest town)			
WELL PURPOSE: <i>MUNICIPAL</i> (home, irrigation, municipal, industrial)			
WELL COMPLETION DATA:			
(1) diameter (inches) <i>2 1/2</i>			
(2) total depth (feet) <i>115</i>			
(3) static water level (feet) <i>41</i> below top of ground. above			
(4) casing <i>P. Lastic</i> , <i>105</i> (material) (depth)			
(size) if telescope see back.			
(5) screen <i>10</i> , <i>105</i> (length) (depth to top)			
<i>2"</i> , <i>P. Lastic</i> (size) (material)			
(6) pump <i>1</i> , <i>11</i> (HP) (yield gpm)			
<i>Elect</i> (type power)			
(7) electric log <i>no</i> (yes or no)			
(organization running log)			
(8) how well bottom plugged <i>Capped</i>			

Miss. Board of Water Comm.


DRILLERS REMARKS:

JUN - 8 1979

RECEIVED

If well telescopes please
sketch and show depths.

GROUND LEVEL

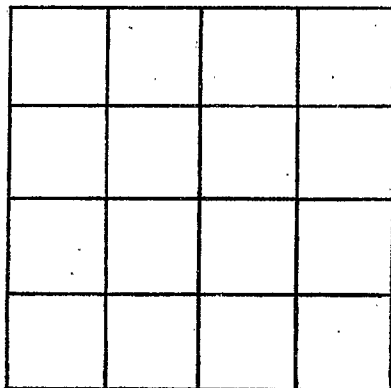

SECTION _____

Please indicate well location X.

ADDITIONAL INFORMATION

If more than one screen,
show locations of each on sketch.