

MISSISSIPPI DEPARTMENT OF NATURAL RESOURCES

Bureau of Land and Water Resources

Southport Mall

P.O. Box 10631

Jackson, Mississippi 39209

WATER WELL DRILLERS LOG

Perry
K 2000
8-27-81

8-27
date well completed

81 Parnell Anderson Perry
firm name county well located

LANDOWNER: Thomas Wilson
Rt 1 Box 65
Brooklyn MS 39425
(mailing address)

description of formations encountered	from	to
Top Soil	0	2
clay	2	19
Sand	19	31
clay	31	85
Sand	85	116
	111	111

WELL LOCATION:
sec. 11 T. 2 N. R. 11 E.
5 S. W.
1/2 miles S of New Augusta
(distance) (direction) (nearest town)

WELL PURPOSE: Home
(home, irrigation, municipal, industrial)

WELL COMPLETION DATA:

- (1) diameter (inches) 2"
- (2) total depth (feet) 116'
- (3) static water level (feet) 50' below top of ground.
- (4) casing PVC, 111' (material) (depth)
- (5) screen 5' 111' (length) (depth to top)
2" PVC (size) (material)
- (6) pump 1 10 (HP) (yield gpm)
Electric (type power)
- (7) electric log NO (yes or no)

(organization running log)

(8) how well bottom plugged Capped

DRILLERS REMARKS:


DEPT. OF NATURAL RESOURCES
BUREAU OF LAND & WATER RESOURCES

OCT - 2 1981

RECEIVED

If well telescopes please sketch and show depths.

GROUND LEVEL

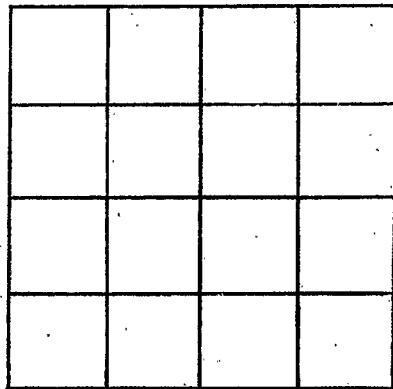

SECTION _____

Please indicate well location X.

ADDITIONAL INFORMATION

If more than one screen,
show locations of each on sketch.