

2012-3N 11W

PERRY

PK 2003

5-17-82

MISSISSIPPI El Aug 82  
BOARD OF WATER COMMISSIONERS  
416 North State Street  
Jackson, Mississippi 39201

G

WATER WELL DRILLERS LOG

May 17 1982 P2 Roy V. West Drilling Perry  
date well completed firm name county well located

LANDOWNER:	description of formations encountered	from	to
Leaf River Forest Prod	CLAY	0	13
New Augusta MS	SAND GRAVEL	13	21
(mailing address)	<del>CLAY</del>	21	450
	SAND	450	480

WELL LOCATION:  
sec 23 T 2 N R 11 E S 5 W  
1 1/2 miles N of New Augusta  
(distance) (direction) (nearest town)

WELL PURPOSE: HOME  
(home, irrigation, municipal, industrial)

- WELL COMPLETION DATA:
- (1) diameter (inches) 2"
  - (2) total depth (feet) 480'
  - (3) static water level (feet) 1' below top of ground.
  - (4) casing PVC, 470' (material) (depth)
  - (size) if telescope see back.
  - (5) screen 10' length, 470' depth to top
  - (size) 2" (material) PVC
  - (6) pump 1/2 (HP), 15 (yield gpm)
  - (type power) REA
  - (7) electric log ~~yes~~ (yes or no)
  - (organization running log)
  - (8) how well bottom plugged WASHUMIVE

DEPT. OF NATURAL RESOURCES  
BUREAU OF LAND & WATER RESOURCES


MAR - 9 1983

DRILLERS REMARKS:

RECEIVED

If well telescopes please sketch and show depths.

GROUND LEVEL

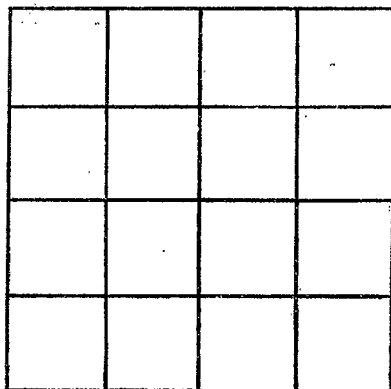

SECTION \_\_\_\_\_

Please indicate well location X.

ADDITIONAL INFORMATION

If more than one screen,  
show locations of each on sketch.