

PERRY

MISSISSIPPI BOARD OF WATER COMMISSIONERS

WATER WELL DRILLERS LOG

L1

8-4-61

Date: 8-4, 1961, Driller: HERMON PERRY County PERRY

(Name)

- (1) Owner of Land: A. E. Woods  
(Name)  
R. J. New August A  
(Address)
- (2) Location: 1/4, 1/4, Sec. 9 T. R.  
3 miles South of W-Augusta  
(distance) (direction) (Nearest Town)
- (3) Topography: Hilly  
(Hilly) (Flat) (Level)
- (4) Purpose of Well: Domestic  
(Domestic Irrigation  
Municipal, Industrial, Other)

Description & Color of Materials  
Sand, Clay, Red Clay, Shell, etc.

Thick-  
ness  
Feet

Depth  
Feet


<u>Sandy Clay</u>	<u>19</u>	<u>19</u>
<u>Chalk</u>	<u>40</u>	<u>59</u>
<u>Sand</u>	<u>31</u>	<u>90</u>

Information upon completion of well:

- (1) Diameter 2 inches.
- (2) Total Depth 90 feet.
- (3) Water Level 53 feet below top of ground.
- (4) Cased to 90, Size 2"
- (5) Screen: Size 2", Length 5'
- (6) Were any formations sealed against pollution?  
\_\_\_\_\_ yes, \_\_\_\_\_ no.

If YES depth of formation \_\_\_\_\_  
Why \_\_\_\_\_

Drillers Remarks: \_\_\_\_\_

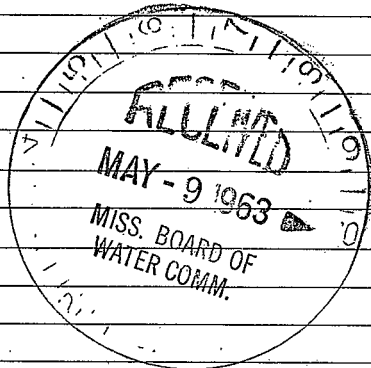

(Use Back Side)

90  
47  
Well No.

Mail this copy to Board of Water Commissioners 429 Miss. St. Jackson, Miss

DEPARTMENT OF CHEMISTRY

RESEARCH REPORT

1961

NO. 12

1961

1961

