

Perry
L 4
8-22-75

MISSISSIPPI
 BOARD OF WATER COMMISSIONERS
 416 North State Street
 Jackson, Mississippi 39201

CODED

WATER WELL DRILLERS LOG

8-22 1975 Panel Anderson Perry
 date well completed firm name county well located

LANDOWNER:
Joseph Rogers
 (mailing address)

description of formations encountered	from	to
<u>Top Soil</u>	<u>0</u>	<u>4</u>
<u>Red Clay</u>	<u>4</u>	<u>28</u>
<u>Coarse Sand</u>	<u>28</u>	<u>30</u>

WELL LOCATION:
 sec. 33 T. 2 N. R. 10 W. 130
7 miles N of Janic
 (distance) (direction) (nearest town)

WELL PURPOSE: HOME
 (home, irrigation, municipal, industrial)

- WELL COMPLETION DATA:
- (1) diameter (inches) 2"
 - (2) total depth (feet) 80'
 - (3) static water level (feet) 25' below top of ground.
 - (4) casing Plastic, 75' (material) (depth)
 (size) if telescope see back.
 - (5) screen 5', 75' (length) (depth to top)
2", Plastic (size) (material)
 - (6) pump 1, 10 (HP) (yield gpm)
Elect (type power)
 - (7) electric log no (yes or no)
 (organization running log)
 - (8) how well bottom plugged Drugged

CODED


REGISTERED
1975

DRILLERS REMARKS:

MISS. RD. UE WATER COMM.

If well telescopes please sketch and show depths.

GROUND LEVEL

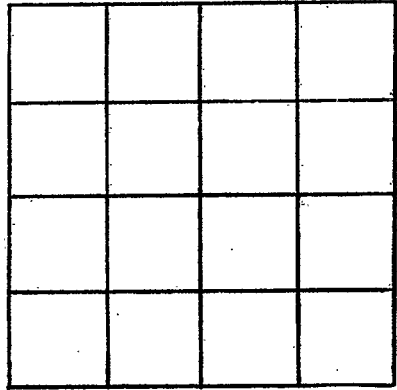

SECTION _____

Please indicate well location X.

ADDITIONAL INFORMATION

If more than one screen, show locations of each on sketch.