

MISSISSIPPI DEPARTMENT OF ENVIRONMENTAL QUALITY

Office of Land and Water Resources

P. O. Box 10631
Jackson, MS 39289-0631

WATER WELL DRILLERS LOG

COUNTY WELL LOCATED <i>Perry</i>	
WELL NUMBER <i>L-34</i>	CODED
DATE WELL COMPLETED <i>12-20-03</i>	

PERMIT NUMBER
NAME OF DRILLING FIRM <i>Truford Well Service</i>

NAME & MAILING ADDRESS OF LANDOWNER <i>Stewart Prince</i>			
<i>PO Box 308</i>			
<i>New Augusta Ms.</i>			
Latitude:			
Longitude:			
WELL LOCATION	SEC <i>4</i>	TOWNSHIP <i>T2</i>	RANGE <i>R10 E</i>
DISTANCE <i>3 1/4</i> Miles	DIRECTION <i>E</i>	NEAREST TOWN <i>New Augusta</i>	
OTHER LANDMARK <i>1/4 N98+198W Beaumont Ms</i>			
WELL PURPOSE (Home Irrigation, Municipal, Industrial, Fish Pond, etc.) <input checked="" type="checkbox"/> Home Irrigation			

PUMP DATA	
PUMP TYPE (Circle One): Submersible, Turbine, <input checked="" type="checkbox"/> Jet, Flowing Well, Other (Describe) _____	
POWER TYPE (Circle One): <input checked="" type="checkbox"/> Electric, Tractor, Diesel, Gasoline, Butane, Other (Describe) _____ H/P _____	

DESCRIPTION OF FORMATIONS ENCOUNTERED	FROM	TO
<i>Clay</i>	<i>0</i>	<i>30</i>
<i>yellow clay</i>	<i>30</i>	<i>52</i>
<i>gray clay</i>	<i>52</i>	<i>135</i>
<i>blue clay</i>	<i>135</i>	<i>195</i>
<i>sand</i>	<i>195</i>	<i>240</i>

WELL DATA

Well Depth <i>240</i>	Casing Diameter (In.) <i>2"</i>	Casing Length (Ft.) <i>230</i>
Type of Casing <i>PVC40</i>	Hole Depth <i>240</i>	Depth to Static Water Level <i>80'</i>
TYPE OF COMPLETION: (Circle One or More): <input checked="" type="checkbox"/> Jet Packed, Underreamed, Telescoped, Natural Development, Open Hole, Other (Describe) _____		
WELL GROUTED TO A DEPTH OF <u><i>10</i></u> FEET Type Grout (circle one): Cement, Bentonite, or <input checked="" type="checkbox"/> Mix		

SCREEN DATA

Diameter - Inches <i>2</i>	Length - Feet <i>10</i>	Slot Size - Inches <i>#8</i>
Screen Type <i>PVC wrapped</i>		Depth to Bottom - Feet <i>240'</i>

RECEIVED	
JAN 08 2004	
BY: OLWR	
Top of Lap Pipe or Reduction in Casing	
FEET	IF TELESCOPED OR MORE THAN ONE SCREEN: USE BACK PAGE

I certify that the well was drilled, constructed and completed in accordance with all applicable Requirements of the Mississippi Department of Environmental Quality and/or the Mississippi Department of Health regulations and state laws.


Michael R. Truford 0408
Signature of Licensed Driller and License No.

1-6-04
Date

Additional Information Required On Back

If well telescopes please sketch and show depths.

GROUND LEVEL

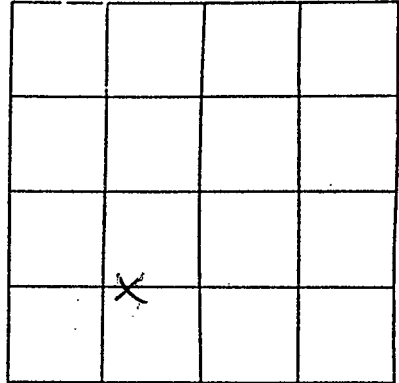

SECTION 26

Please indicate well location X.

Pump Capacity (GPM)	No. of Stages	Setting Depth
8-15	2	100 FT.

PUMP TEST

Well yielded 7 GPM with
 a drawdown of 6' ft.
 after 1 hours of pumping

LOG DATA

TYPE OF LOG RUN (Circle One): No Log Run, Electric, Gamma Ray, Density, Sonic, Neutron, Other (Describe) _____

Name of Organization Running Log _____

GEOLOGIC DATA (Office Use Only)

Surface Elev.	Geologic Unit	Unit Thickness	Depth to Top
Subs. SWL	Date	Analysis	Aquifer Test

Driller's Remarks

If more than one screen, show location of each on sketch.