

Perry  
 L 2000  
 11/2/77

**C. P. CLARK**  
 MISSISSIPPI WATER WELL DRILLING  
 BOARD OF WATER COMMISSIONERS ROUTE 2  
 416 North State Street LAUREL, MISS. 39440  
 Jackson, Mississippi 39201

**WATER WELL DRILLERS LOG**

11/2 1977 C. P. Clark Perry Co  
 date well completed firm name county well located

LANDOWNER: Carl Bigley  
Rt #1 Box 57  
Brooklyn Miss 39425  
 (mailing address)

description of formations encountered	from	to
Clay	0	15
Sand	15	57
Clay	57	275
Sand fine Sand	266	275
Good Sand	275	303

WELL LOCATION:  
 sec. 33 T. 2 (N) R. 10 (E)  
 S (W)  
9 miles S of New Augusta  
 (distance) (direction) (nearest town)

NOTE: Still in Sand

WELL PURPOSE: Home  
 (home, irrigation, municipal, industrial)

- WELL COMPLETION DATA:
- (1) diameter (inches) 2
  - (2) total depth (feet) 303
  - (3) static water level (feet) 71 below above top of ground.
  - (4) casing Galv. Iron 298  
 (material) (depth)
  - (size) if telescope see back.
  - (5) screen 5 298  
 (length) (depth to top)
  - 1/4 Solid 55  
 (size) (material)
  - (6) pump 15 with air  
 (HP) (yield gpm)
  - (type power)
  - (7) electric log NO  
 (yes or no)
  - (organization running log)
  - (8) how well bottom plugged BWU


**RECEIVED**  
 NOV 17 1977

DRILLERS REMARKS: Customer  
to install new pump

MISS. BD. OF WATER COMMISSIONERS

If well telescopes please sketch and show depths.

GROUND LEVEL

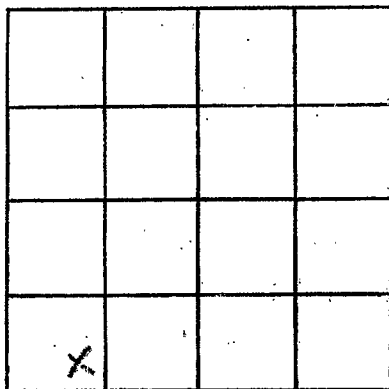

SECTION 33

Please indicate well location X.

ADDITIONAL INFORMATION

If more than one screen, show locations of each on sketch.