

Perry
L 2004
10-11-79
10-11-79

MISSISSIPPI
 BOARD OF WATER COMMISSIONERS
 416 North State Street
 Jackson, Mississippi 39201

WATER WELL DRILLERS LOG

TOM GRIFFITH Perry

date well completed

firm name

county well located

LANDOWNER:
Marvion Brehand
 (mailing address)

description of fomations encountered	from	to
Top soil	0	1
sland	1	30
chalk	30	190
Sand	190	230

WELL LOCATION:
 sec. 6 T. 20 N. R. 10 E.
 S. W.
15 miles South of New Augusta
 (distance) (direction) (nearest town)

WELL PURPOSE: Home
 (home, irrigation, municipal, industrial)

- WELL COMPLETION DATA:
- (1) diameter (inches) 2"
 - (2) total depth (feet) 230'
 - (3) static water level (feet) 100' ^{below}/_{above} top of ground.
 - (4) casing Plastic, 110'
 (material) (depth)
2" if telescope see back.
 (size)
 - (5) screen 20', 110'
 (length) (depth to top)
2", Plastic
 (size) (material)
 - (6) pump 1 1/2
 (HP) (yield gpm)
Electric
 (type power)
 - (7) electric log NO
 (yes or no)
NO
 (organization running log)
 - (8) how well bottom plugged B.U.V.

DEPT. OF NATURAL RESOURCES
 BUREAU OF LAND & WATER RESOURCES


NOV 21 1979

RECEIVED

DRILLERS REMARKS:

If well telescopes please sketch and show depths.

GROUND LEVEL

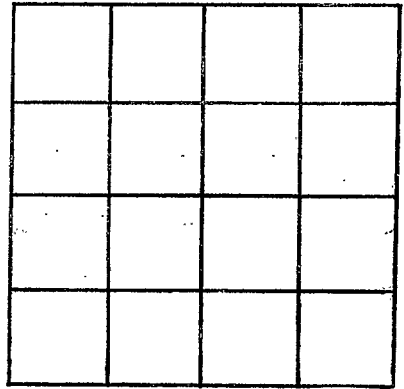

SECTION _____

Please indicate well location X.

ADDITIONAL INFORMATION

If more than one screen,
show locations of each on sketch.