

Perry
 L 2000
 9-9-80

MISSISSIPPI
 BOARD OF WATER COMMISSIONERS
 416 North State Street
 Jackson, Mississippi 39201

WATER WELL DRILLERS LOG

Perry
~~L 2000~~

9-9-80
 date well completed

19 Farnell Anderson
 firm name

county well located

LANDOWNER: <u>Harlan Clark</u>	description of formations encountered	from	to
<u>Rt 1 Box 964</u> <u>Brooklyn Ms</u> (mailing address)			
WELL LOCATION: sec. <u>20</u> T. <u>2</u> N. R. <u>10</u> E. W. <u>W</u> <u>6</u> miles <u>S</u> of <u>New Augusta</u> (distance) (direction) (nearest town)	<u>top soil</u>	<u>0</u>	<u>3</u>
	<u>Clay</u>	<u>3</u>	<u>21</u>
	<u>Fine Sand</u>	<u>21</u>	<u>34</u>
	<u>Coarse Sand</u>	<u>30</u>	<u>43</u>
WELL PURPOSE: <u>Home</u> (home, irrigation, municipal, industrial)			
WELL COMPLETION DATA: (1) diameter (inches) <u>2"</u>			
(2) total depth (feet) <u>45'</u>			
(3) static water level (feet) <u>30</u> below top of ground.			
(4) casing <u>Plastic</u> <u>38'</u> (material) (depth)			
(size) if telescope see back.			
(5) screen <u>5ft</u> <u>38'</u> (length) (depth to top)			
(size) (material)			
(6) pump <u>1</u> <u>8</u> (HP) (yield gpm)			
<u>Electricity</u> (type power)			
(7) electric log <u>NO</u> (yes or no)			
(organization running log)			
(8) how well bottom plugged <u>Copper</u>			
DRILLERS REMARKS:			


DEPT. OF NATURAL RESOURCES
 BUREAU OF LAND & WATER RESOURCES

OCT 14 1980

RECEIVED

If well telescopes please
sketch and show depths.

GROUND LEVEL

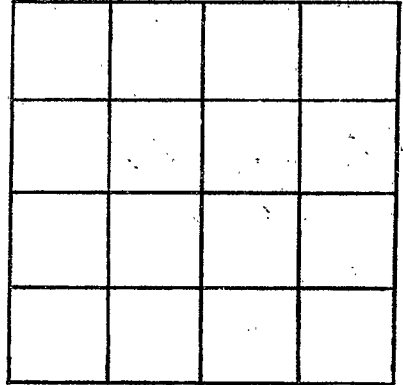

SECTION _____

Please indicate well location X.

ADDITIONAL INFORMATION

If more than one screen,
show locations of each on sketch.