

MISSISSIPPI DEPARTMENT OF NATURAL RESOURCES
Bureau of Land and Water Resources
 Southport Mall
 P.O. Box 10631
 Jackson, Mississippi 39209
WATER WELL DRILLERS LOG

Perry
C 2003

Jan. 23, 1982 Cochran Brothers Drilling Service PERRY
 date well completed firm name county well located

LANDOWNER:
Clayd Fillingane
Rt. 2 Brooklyn
 (mailing address)

description of formations encountered	from	to
TOP Soil	0	2
Red clay	2	8
Red sand	8	19
GRAY CLAY	19	24
sand	24	68
Blue clay	68	171
Blue shale	171	195
Blue clay	195	260
fine sand	260	266
Blue clay	266	289
sand	289	320

WELL LOCATION:
 sec. 33T 2N 5S R 10E
9 miles S of Downs
 (distance) (direction) (nearest town)

WELL PURPOSE: none
 (home, irrigation, municipal, industrial)

WELL COMPLETION DATA:

- diameter (inches) 2"
- total depth (feet) 320'
- static water level (feet) 22 below above top of ground.
- casing PVC, 310'
 (material) (depth)
 (size) if telescope see back.
- screen 10' 310'
 (length) (depth to top)
2" PVC
 (size) (material)
- pump 1 6
 (HP) (yield gpm)
elec
 (type power)
- electric log no
 (yes or no)
 (organization running log)
- how well bottom plugged value

DRILLERS REMARKS:


DEPT. OF NATURAL RESOURCES
 BUREAU OF LAND & WATER RESOURCES

FEB 23 1982

RECEIVED

If well telescopes please sketch and show depths.

GROUND LEVEL

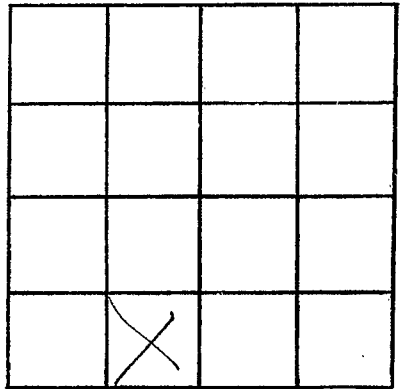

SECTION 33

Please indicate well location X.

ADDITIONAL INFORMATION

If more than one screen,
show locations of each on sketch.