

MISSISSIPPI DEPARTMENT OF NATURAL RESOURCES
Bureau of Land and Water Resources
 Southport Mall
 P.O. Box 10631
 Jackson, Mississippi 39209
WATER WELL DRILLERS LOG

Perry
L 2004

Sep. 1-1982
 date well completed

Cochran Bore Drilling
 firm name

PERRY
 county well located

LANDOWNER:	description of formations encountered	from	to
<u>Jack Newell</u> <u>Rt 2 Richton</u> (mailing address)			
	<u>Red clay</u>	<u>2</u>	<u>8</u>
	<u>Red sand</u>	<u>8</u>	<u>21</u>
	<u>GRAY clay</u>	<u>21</u>	<u>88</u>
	<u>Blue Clay</u>	<u>88</u>	<u>131</u>
	<u>Sand</u>	<u>131</u>	<u>150</u>
WELL LOCATION:			
sec. <u>2</u> T. <u>N</u> R. <u>10</u> E.			
<u>1</u> miles (distance) <u>S</u> (direction) of <u>1</u> (nearest town)			
WELL PURPOSE: <u>dom</u> (home, irrigation, municipal, industrial)			
WELL COMPLETION DATA:			
(1) diameter (inches) <u>2"</u>			
(2) total depth (feet) <u>150'</u>			
(3) static water level (feet) <u>21</u> <u>below</u> top of ground.			
(4) casing <u>PVC</u> <u>140'</u> (material) (depth)			
<u> </u> if telescope see back. (size)			
(5) screen <u>10'</u> <u>140'</u> (length) (depth to top)			
<u>2"</u> <u>PVC</u> (size) (material)			
(6) pump <u>1</u> <u>7</u> (HP) (yield gpm)			
<u>Elc</u> (type power)			
(7) electric log <u>NO</u> (yes or no)			
<u> </u> (organization running log)			
(8) how well bottom plugged <u>valve</u>			

DEPT. OF NATURAL RESOURCES
 BUREAU OF LAND & WATER RESOURCES


NOV 17 1982

RECEIVED

DRILLERS REMARKS:

If well telescopes please sketch and show depths.

GROUND LEVEL

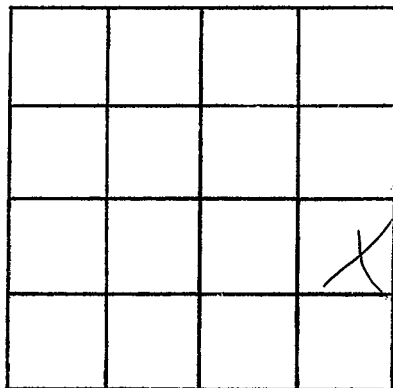

SECTION 2

Please indicate well location X.

ADDITIONAL INFORMATION

If more than one screen,
show locations of each on sketch.