

MISSISSIPPI DEPARTMENT OF NATURAL RESOURCES

Bureau of Land and Water Resources

Southport Mall

P.O. Box 10631

Jackson, Mississippi 39209

WATER WELL DRILLERS LOG

Perry  
L2005

10-9

19 85

Parnell Anderson Perry

date well completed

firm name

county well located

LANDOWNER:

Gae Gilre

description of formations encountered

from

to

NA

Top Soil

0

2

Clay

3

18

Sand

18

26

Clay

26

31

Sand

31

47

(mailing address)

WELL LOCATION:

sec. 33 T. 2N

R. 10 E

W

6

miles

5

(direction)

of New Augusta

(distance)

(direction)

(nearest town)

WELL PURPOSE:

HOME

(home, irrigation, municipal, industrial)

WELL COMPLETION DATA:

(1) diameter (inches)

2

(2) total depth (feet)

47

(3) static water level (feet)

29

below above

top of ground.

(4) casing

PVC

42

(material)

(depth)

(size)

if telescope see back.

(5) screen

5'

42

(length)

(depth to top)

(size)

(material)

(6) pump

(HP)

(yield gpm)

Flec

(type power)


(7) electric log

(yes or no)

(organization running log)

(8) how well bottom plugged

Cap

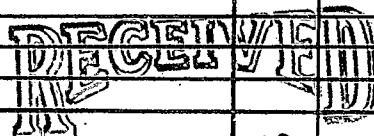


Department of Natural Resources  
Bureau of Land & Water Resources

DRILLERS REMARKS:

If well telescopes please sketch and show depths.

GROUND LEVEL

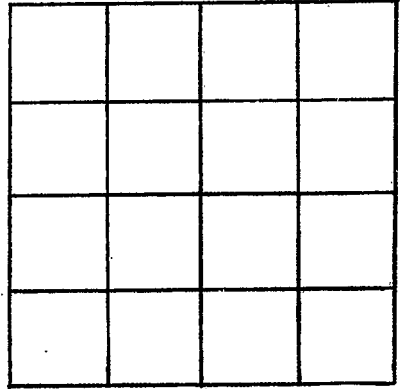

SECTION \_\_\_\_\_

Please indicate well location X.

ADDITIONAL INFORMATION

If more than one screen,  
show locations of each on sketch.