

CODED

M9

WATER WELL DRILLERS LOG

4-19-61

Date: 4/19, 1961, Driller: _____ County: Jerry

(Name)

(1) Owner of Land: Jerry County Shale

(Name)

Beaumont Miss

(Address)

(2) Location: SE 1/4, SE 1/4, Sec. 6, T. 29,

1 miles S. W. of Beaumont

(distance)

(direction)

(Nearest Town)

(3) Topography: (Hilly) (Flat) (Level)

(4) Purpose of Well: School

(Domestic Irrigation
Municipal, Industrial, Other)

Description & Color of Materials Sand, Clay, Red Clay, Shell, etc.	Thick- ness Feet	Depth Feet
0-1 Red Clay	1	
1-12 Red Sand	5	
12-20 Blue Clay	19 1/2	
20-25 Sand streaks	5	
25-220 Sand fine	25	
220-315 Blue Clay		
315-413 Sandy streaks		
413-421 Sand		
421-490 Clay + ss.		
490-510 Sand + Clay		
510-530 Sandy streaks		
530-537 Sand		
537-555 Clay		
555-639 Sand		

Information upon completion of well:


- (1) Diameter 4 inches.
- (2) Total Depth _____ feet.
- (3) Water Level _____ feet below top of ground.
- (4) Cased to _____, Size _____
- (5) Screen: Size _____, Length _____
- (6) Were any formations sealed against pollution?
_____ yes, _____ no.

If YES depth of formation _____

Why _____

Drillers Remarks: _____

CODED

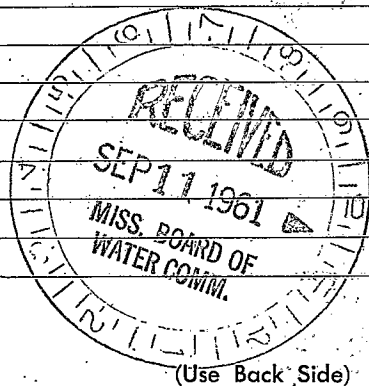

Well No.

