

PERRY
M 10
9-23-71

MISSISSIPPI
BOARD OF WATER COMMISSIONERS
416 North State Street
Jackson, Mississippi 39201

WATER WELL DRILLERS LOG

9-23 1971 CH&H Drilling
date well completed firm name

CODED
county well located

LANDOWNER: Wade
Creekside
Beverly Ann
(mailing address)

description of formations encountered	from	to
<u>Sand</u>	<u>1</u>	<u>14</u>
<u>" "</u>	<u>14</u>	<u>21</u>
<u>" "</u>	<u>31</u>	<u>32</u>
<u>" "</u>	<u>52</u>	<u>73</u>
<u>" "</u>	<u>73</u>	<u>85</u>

WELL LOCATION:
sec 23 T 2 N R 9 E
1/2 miles west of McLean
(distance) (direction) (nearest town)

WELL PURPOSE:
(home, irrigation, municipal, industrial)
home

- WELL COMPLETION DATA:
- (1) diameter (inches) 2"
 - (2) total depth (feet) 85
 - (3) static water level (feet) 40 below top of ground
 - (4) casing Plastic, 1 1/2" (material) (depth)
(size) if telescope see back.
 - (5) screen 10/16", 1 1/2" (length) (depth to top)
2 1/2", Plastic (size) (material)
 - (6) pump REA (HP) (yield gpm)
(type power)
 - (7) electric log (yes or no)
 - (organization running log)
 - (8) how well bottom plugged Before well

CODED

NOV 8 1971


MISS. BD. OF
WATER COMMISSIONERS

DRILLERS REMARKS:
Tapped

85

If well telescopes please sketch and show depths.

GROUND LEVEL

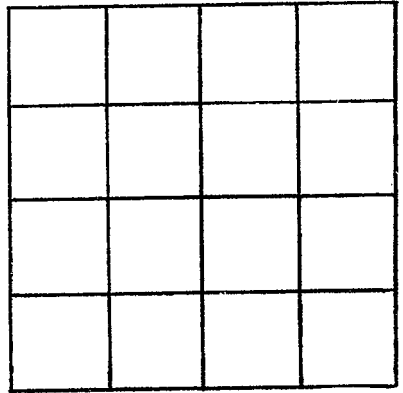

SECTION _____

Please indicate well location X.

ADDITIONAL INFORMATION

If more than one screen, show locations of each on sketch.