

**MISSISSIPPI  
BOARD OF WATER COMMISSIONERS**  
416 North State Street  
Jackson, Mississippi 39201

**WATER WELL DRILLERS LOG**

**PERRY**  
**M 14**  
**3-68**

3/25 1968 STR PERRY  
date well completed firm name county well located

LANDOWNER: Town of Beaumont  
Beaumont, Miss  
(mailing address)

WELL LOCATION:  
sec 5 T 2 N R 9 E  
S W  
0.2 miles City of City  
(distance) (direction) (nearest town)

WELL PURPOSE: Team  
(home, irrigation, municipal, industrial)

WELL COMPLETION DATA:

(1) diameter (inches) 2"

(2) total depth (feet) 575

(3) static water level (feet) Flow below above top of ground.

(4) casing Alu 565  
(material) (depth)

2"  
(size) if telescope see back.

(5) screen 10 ft 565  
(length) (depth to top)

2" 5/8  
(size) (material)

(6) pump 1 75  
(HP) (yield gpm)


Alu  
(type power)

(7) electric log no  
(yes or no)

no  
(organization running log)

(8) how well bottom plugged valve

description of formations encountered	from	to
Red Clay	0	4
White Sand	4	15
Clay - Blue	15	65
Clay White	65	110
Clay Brown	110	122
Clay Blue & Grey	122	185
Sand Strips & Shell	185	210
Blue Shell	210	310
Sand Strips & Blue Clay	310	440
Fine Blue Sand	440	478
Blue Clay	478	481
Fine Blue Sand	481	498
Clay - Blue	498	508
Fine Sand	508	542
CW B Sand	542	575
Loam	575	579
Fine Gr Sand	579	592

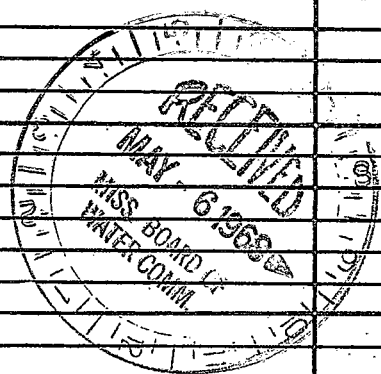

DRILLERS REMARKS:

If well telescopes please sketch and show depths.

GROUND LEVEL

		X	

SECTION         

Please indicate well location X.

ADDITIONAL INFORMATION

If more than one screen,  
show locations of each on sketch.