

PERRY
M 15
11-8-69

MISSISSIPPI
BOARD OF WATER COMMISSIONERS
416 North State Street
Jackson, Mississippi 39201
WATER WELL DRILLERS LOG

CODED

11/8 1969 STR Perry
date well completed firm name county well located

LANDOWNER: Jimmy Howse
Hattiesburg, Miss
(mailing address)

description of formations encountered	from	to
Sandy Clay	0	10
Fine Sand	10	40
Blue Clay	40	70
Fine Sand	70	80
Sandy Clay	80	105
CWS&S	105	115

WELL LOCATION:
sec 23 T 2 N R 9 E
3 miles N of McLain
(distance) (direction) (nearest town)

WELL PURPOSE: Home
(home, irrigation, municipal, industrial)

- WELL COMPLETION DATA:
- (1) diameter (inches) 2"
 - (2) total depth (feet) 115
 - (3) static water level (feet) 70 below above top of ground.
 - (4) casing plastic, 110,
(material) (depth)
2"
(size) if telescope see back.
 - (5) screen 5ft, 110
(length) (depth to top)
2", plastic
(size) (material)
 - (6) pump 3/4, 200 Hc
(HP) (yield gpm)
1/2
(type power)
 - (7) electric log
(yes or no)

(organization running log)
 - (8) how well bottom plugged Value


DRILLERS REMARKS:

NOV 21 1969

MISSISSIPPI BOARD OF WATER COMMISSIONERS

If well telescopes please sketch and show depths.

GROUND LEVEL

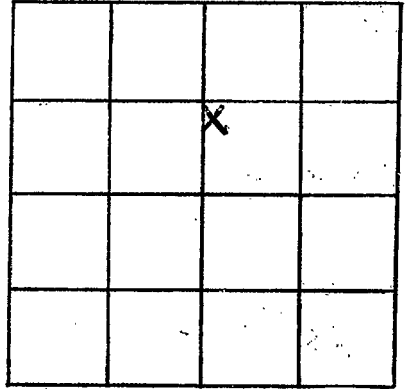

SECTION 23

Please indicate well location X.

ADDITIONAL INFORMATION

If more than one screen,
show locations of each on sketch.