

Perry
M16
12-5-69

MISSISSIPPI
 BOARD OF WATER COMMISSIONERS
 416 North State Street
 Jackson, Mississippi 39201

CODED
 CODED

WATER WELL DRILLERS LOG

12-5 1969 SJR Perry
 date well completed firm name county well located


LANDOWNER: <u>Leon Harrison</u>	description of formations encountered	from	to
<u>Lot 1</u> <u>McLean, Miss</u> (mailing address)	<u>Sand</u>	<u>0</u>	<u>20</u>
WELL LOCATION: sec <u>26</u> T <u>2</u> N <u>9</u> E S W <u>2</u> miles <u>W</u> of <u>McLean</u> (distance) (direction) (nearest town)	<u>Sandy Clay</u>	<u>20</u>	<u>30</u>
WELL PURPOSE: <u>Home</u> (home, irrigation, municipal, industrial)	<u>Fine Sand</u>	<u>30</u>	<u>70</u>
WELL COMPLETION DATA:	<u>Gravel</u>	<u>70</u>	<u>100</u>
(1) diameter (inches) <u>2"</u>	<u>Fine Sand</u>	<u>100</u>	<u>110</u>
(2) total depth (feet) <u>130</u>	<u>Cow B Sand</u>	<u>110</u>	<u>130</u>
(3) static water level (feet) <u>20</u> below above top of ground.			
(4) casing <u>plastic</u> , <u>12.5</u> , (material) (depth) <u>2"</u> (size) if telescope see back.			
(5) screen <u>5/8"</u> , <u>12.5</u> (length) (depth to top) <u>2"</u> , <u>plastic</u> (size) (material)			
(6) pump <u>1</u> , <u>1200k.</u> (HP) (yield gpm) <u>1/2</u> (type power)			
(7) electric log _____ (yes or no) _____ (organization running log)			
(8) how well bottom plugged <u>Valv.</u>			
DRILLERS REMARKS:			

DEC 23 1969

MISS. Bd. OF
 WATER COMM.

If well telescopes please sketch and show depths.

GROUND LEVEL

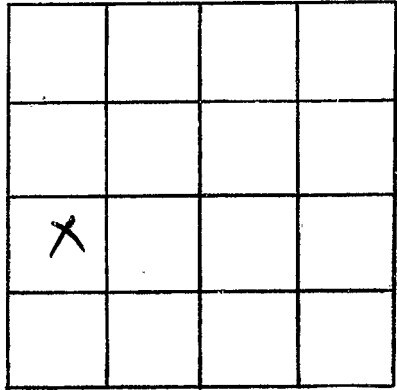

SECTION 26

Please indicate well location X.

ADDITIONAL INFORMATION

If more than one screen,
show locations of each on sketch.