

Perry Co  
M 17  
1-21-70

MISSISSIPPI  
BOARD OF WATER COMMISSIONERS  
416 North State Street  
Jackson, Mississippi 39201

WATER WELL DRILLERS LOG

1-21-1970 Leonard Pharis Perry  
date well completed firm name county well located

LANDOWNER: <u>Van D.</u>	description of formations encountered	from	to
<u>Sandy</u> <u>Hatkeburg miss</u> (mailing address)	<u>Sand + gravel</u>	<u>0</u>	<u>145</u>
WELL LOCATION: sec. <u>11</u> T. <u>2</u> N R. <u>9</u> E <u>3</u> miles <u>N</u> of <u>Beaumont</u> (distance) (direction) (nearest town)	<u>chalk</u>	<u>145</u>	<u>240</u>
WELL PURPOSE: <u>Municipal</u> (home, irrigation, municipal, industrial)	<u>S. pits</u>	<u>240</u>	<u>270</u>
WELL COMPLETION DATA:			
(1) diameter (inches) <u>2 1/2</u>			
(2) total depth (feet) <u>270</u>			
(3) static water level (feet) <u>710</u> <sup>Below</sup> above top of ground.			
(4) casing <u>Galv</u> <u>147</u> (material) (depth) (size) If telescope see back.			
(5) screen <u>✓</u> <u>✓</u> (length) (depth to top) (size) (material)			
(6) pump <u>✓</u> <u>✓</u> (HP) (yield gpm) (type power)			
(7) electric log <u>NO</u> (yes or no) (organization running log)			
(8) how well bottom plugged <u>NONE</u>			
DRILLERS REMARKS: <u>well has no screen</u> <u>open hole goes to gal pump</u> <u>well not drilled for gravel</u> <u>pit</u>			


COPIED

COPIED  
MAR 12 1970

MISS. BD. OF  
WATER COMMISSIONERS

If well telescopes please sketch and show depths.

GROUND LEVEL

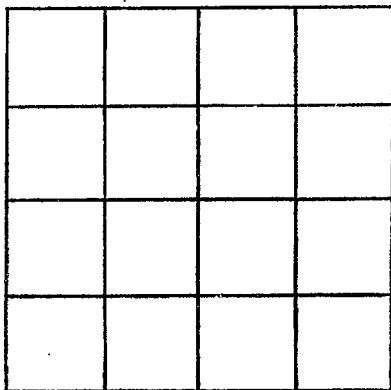

SECTION \_\_\_\_\_

Please indicate well location X.

ADDITIONAL INFORMATION

If more than one screen, show locations of each on sketch.