

PERRY  
M18  
8-28-70

MISSISSIPPI  
BOARD OF WATER COMMISSIONERS  
416 North State Street  
Jackson, Mississippi 39201

CODED

WATER WELL DRILLERS LOG

8-28-70 date well completed  
C.H.D. Dullings Co. firm name  
Perry county well located

LANDOWNER: Roy J. Gordon

Lens Well  
McClain, Miss.  
(mailing address)

Description of formations encountered

from to

Sand clay. 1 91.  
Extra. Hard Clay 91 112.  
Fert Sand. 112 133  
Dark Blue Sand 133 150

WELL LOCATION:

sec. 24 T 20 N R 9 E  
S (W)  
10 miles W of McClain  
(distance) (direction) (nearest town)

WELL PURPOSE: Home  
(home, irrigation, municipal, industrial)

WELL COMPLETION DATA:

- (1) diameter (inches) 3"
- (2) total depth (feet) 150 ft
- (3) static water level (feet) 14' below top of ground
- (4) casing plastic 140 ft (material) (depth)  
3" (size) If telescope see back.
- (5) screen 10 ft, 150 ft (length) (depth to top)  
2" Plastic (size) (material)
- (6) pump 1 hp 500 gpm (HP) (yield gpm)  
R.E.A. (type power)
- (7) electric log (yes or no)

CODED

Total Depth 150 ft

(organization running log)

(8) how well bottom plugged Back Wash Valve

OCT 2 1970


DRILLERS REMARKS:

Direction taken from Mr. Davis Land Deal

MISS. BD. OF WATER COMMISSIONERS

If well telescopes please sketch and show depths.

GROUND LEVEL

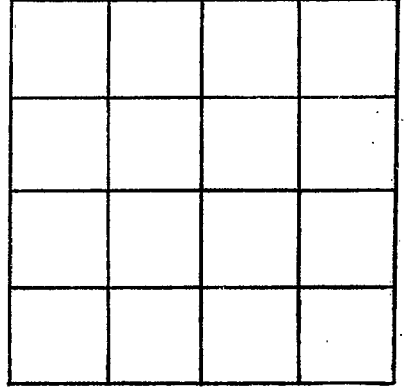

SECTION \_\_\_\_\_

Please indicate well location X.

ADDITIONAL INFORMATION

If more than one screen,  
show locations of each on sketch.