

Perry
M '19
5-25-70

MISSISSIPPI
BOARD OF WATER COMMISSIONERS
416 North State Street
Jackson, Mississippi 39201

CODED

WATER WELL DRILLERS LOG

5-25-1970 date well completed
70 C H + D Well Drilling Perry firm name
Perry county well located


LANDOWNER:	description of formations encountered	from	to
Benita Farley Pt 1.	Clay	1	18
Beaumont Miss (mailing address)	Blue Clay	18	81
WELL LOCATION: sec 24 T 2 N R 9 E 4 1/2 miles S.W. of M ^o Lane (distance) (direction) (nearest town)	Brown + Blue Clay mixed	81	102
WELL PURPOSE: home (home, irrigation, municipal, industrial)	Coal + clay	102	144
WELL COMPLETION DATA: (1) diameter (inches) 2" (2) total depth (feet) 157 (3) static water level (feet) 18 below top of ground. (4) casing Gal (material) 147 (depth) 2" (size) If telescope see back. (5) screen 10ft. (length) 147 (depth to top) 2" (size) plastic (material) (6) pump 1 1/2 HP (HP) 500 gpm (yield gpm) R.P.A. (type power) (7) electric log (yes or no) (organization running log) (8) how well bottom plugged Back wash Valve	Water sand	144	157
DRILLERS REMARKS:	Total depth		157ft.

CODED
JUN 25 1970

MISS. Bd. OF
WATER COMM.

If well telescopes please sketch and show depths.

GROUND LEVEL

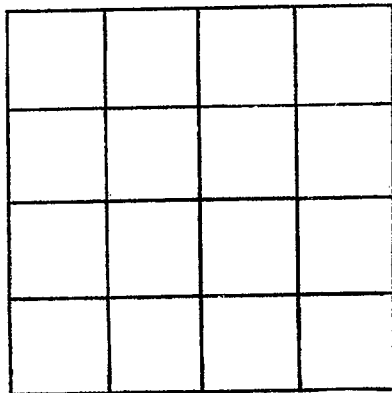

SECTION _____

Please indicate well location X.

ADDITIONAL INFORMATION

If more than one screen, show locations of each on sketch.