

Perry
M 30
6-25-70

MISSISSIPPI
BOARD OF WATER COMMISSIONERS
416 North State Street
Jackson, Mississippi 39201

CODED

WATER WELL DRILLERS LOG

6-25-70 date well completed
1970 C H & D Well Drilling Perry firm name
Perry county well located

LANDOWNER: Bonata Family
RT 1

description of formations encountered	from	to
Clay	1	18
Blue Clay	18	70
Brown & Blue (clay)		
metal	70	91
clay sand	91	134
water sand	134	157

Reaumont Miss.
(mailing address)

WELL LOCATION:
sec. 24 T 2 N R 9 E
4 1/2 miles S of Sur of main line
(distance) (direction) (nearest town)

WELL PURPOSE: home
(home, irrigation, municipal, industrial)

Total depth 157 ft

WELL COMPLETION DATA:

- (1) diameter (inches) 2"
- (2) total depth (feet) 157 ft
- (3) static water level (feet) 50 below top of ground
- (4) casing gal. 147 ft.
(material) (depth)
- (size) if telescope see back.
- (5) screen 10 157.
(length) (depth to top)
- 2" plastic
(size) (material)
- (6) pump 1 hp 450 gal/hr
(HP) (yield gpm)
- R & A
(type power)
- (7) electric log _____
(yes or no)

CODED

(organization running log)


(8) how well bottom plugged Back
wash valve

DRILLERS REMARKS:

JUL 13 1970

If well telescopes please sketch and show depths.

GROUND LEVEL

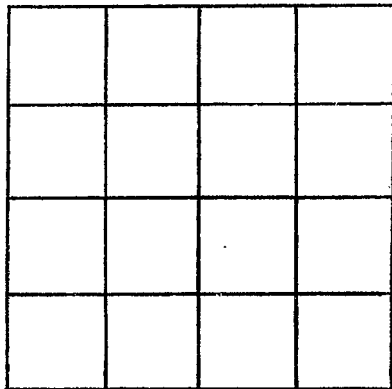

SECTION _____

Please indicate well location X.

ADDITIONAL INFORMATION

If more than one screen, show locations of each on sketch.