

PERRY  
M 21  
2-8-72

MISSISSIPPI  
BOARD OF WATER COMMISSIONERS  
416 North State Street  
Jackson, Mississippi 39201

WATER WELL DRILLERS LOG **CODED**

Feb 8 - 1972 Cochran Drilling Service Perry  
date well completed firm name county well located

LANDOWNER: James Cowart  
R 71  
Beautmont Miss  
(mailing address)

description of formations encountered	from	to
Top soil	0	2
Brown clay	2	14
red clay	14	29
Gray clay	29	67
...	67	85

WELL LOCATION:  
sec. 29 T 2 N R 9 E  
27 S W  
3 miles W of Littleport  
(distance) (direction) (nearest town)

WELL PURPOSE: home  
(home, irrigation, municipal, industrial)

- WELL COMPLETION DATA:
- (1) diameter (inches) 2"
  - (2) total depth (feet) 85'
  - (3) static water level (feet) 60' below top of ground.
  - (4) casing P.V.C. 80' (material) (depth)
  - (size) if telescope see back.
  - (5) screen 5' 80' (length) (depth to top)
  - 2" P.V.C. (size) (material)
  - (6) pump 1 (HP) 6 1/2 (yield gpm)
  - Elect (type power)
  - (7) electric log (yes or no)
  - (organization running log)
  - (8) how well bottom plugged valve

**CODED**


MAY 9 - 1972

MISS. Bd. of Water Comm. Jackson, Miss.

DRILLERS REMARKS:

If well telescopes please sketch and show depths.

GROUND LEVEL

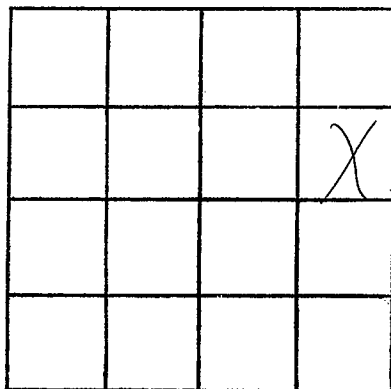

SECTION 27

Please indicate well location X.

ADDITIONAL INFORMATION

If more than one screen,  
show locations of each on sketch.