

Perry
M213
8-17-73

MISSISSIPPI
BOARD OF WATER COMMISSIONERS
416 North State Street
Jackson, Mississippi 39201

CODED

WATER WELL DRILLERS LOG

August 17 1973 Cochran Drillers Perry
date well completed firm name county well located

LANDOWNER:
Alton D. Fulanks
Rt. 1, Box 40 Beaumont
(mailing address)

description of formations encountered	from	to
Top soil	0	2
red clay	2	7
red sand	7	14
brown clay	14	22
gray clay	22	31
sand	31	50

WELL LOCATION:
sec. 4 T. 25 S. R. 9 E. W. 1
1 miles South of Beaumont
(distance) (direction) (nearest town)

WELL PURPOSE: home
(home, irrigation, municipal, industrial)

WELL COMPLETION DATA:
(1) diameter (inches) 2"
(2) total depth (feet) 50'
(3) static water level (feet) 11 below top of ground.
(4) casing PVC 45' (material) (depth)
if telescope see back.
(5) screen 5' 45' (length) (depth to top)
2" PVC (size) (material)
(6) pump 1 (HP) 6 (yield gpm)
Elect (type power)
(7) electric log NO (yes or no)
(organization running log)
(8) how well bottom plugged


CODED

DRILLERS REMARKS:

NOV 5 1973

If well telescopes please sketch and show depths.

GROUND LEVEL

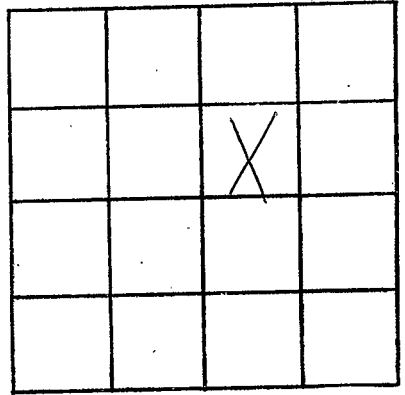

SECTION 4

Please indicate well location X.

ADDITIONAL INFORMATION

If more than one screen, show locations of each on sketch.