

Perry
M24
5/26/78

MISSISSIPPI
BOARD OF WATER COMMISSIONERS
416 North State Street
Jackson, Mississippi 39201 **CODED**

WATER WELL DRILLERS LOG

May 26 1978 Porter Drilling & Ship Perry
date well completed firm name county well located

LANDOWNER: Annie Sellers
P.O. Box 34
McLain Miss.
(mailing address)

| description of formations encountered | from | to |
|---------------------------------------|------|------|
| | clay | 0 |
| sand | 6 | 100 |
| sand & gravel | 100 | 133 |
| blue clay | 133 | 226 |
| course sand & gravel | 226 | 255' |
| stagnant water still in sand | | |

WELL LOCATION:
sec 14 T 2 (N) R 9 E
1 1/2 miles NW of McLain
(distance) (direction) (nearest town)

WELL PURPOSE: Home
(home, irrigation, municipal, industrial)

WELL COMPLETION DATA:
(1) diameter (inches) 2"
(2) total depth (feet) 255'
(3) static water level (feet) 14' below top of ground. above
(4) casing galv. 250'
(material) (depth)
2" (size) if telescope see back.
(5) screen 5' 250
(length) (depth to top)
2 1/2" 10 slot S.S.
(size) (material)
(6) pump 1/2 15
(HP) (yield gpm)
elec. 30 gal flow
(type power)
(7) electric log no
(yes or no)
(organization running log)

2 shell traps - bronze screen
CODED

(8) how well bottom plugged
2' back work water


DRILLERS REMARKS:

RECEIVED
JUN 19 1978

MISS. BD. OF WATER COMM

If well telescopes please sketch and show depths.

GROUND LEVEL

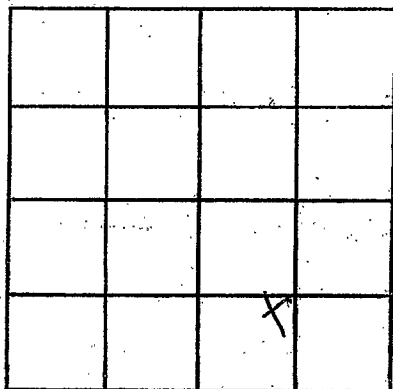

SECTION 14

Please indicate well location X.

ADDITIONAL INFORMATION

If more than one screen, show locations of each on sketch.