

PERRY
M-25
8-15-80

MISSISSIPPI
BOARD OF WATER COMMISSIONERS
416 North State Street
Jackson, Mississippi 39201

WATER WELL DRILLERS LOG

CODED

8-15-80 date well completed
80 Ferguson Well Service Perry firm name
Perry county well located

LANDOWNER: Richard Batt

description of formations encountered

from to

(mailing address)

WELL LOCATION:

sec. 4 T. 2 N. R. 9 E. W
5 miles (distance) NE (direction) of Hinton (nearest town)

Top Soil	0	10
Loam	10	15
Gravel	15	22
White Clay	22	30
Sand	30	40
Blue Clay	40	90
Blue Ridge Sand	90	115
Med Sand	115	130

WELL PURPOSE:

(home irrigation, municipal, industrial)

WELL COMPLETION DATA: 8-15-80

- (1) diameter (inches) 4"
- (2) total depth (feet) 130'
- (3) static water level (feet) 21' below above top of ground.
- (4) casing PVC (material), 120' (depth)
4" (size) if telescope see back.
- (5) screen 10' (length), 120' (depth to top)
4" (size), PVC (material).
- (6) pump 3/4 (HP), 20 (yield gpm)
1/2 (type power)
- (7) electric log (yes or no)

(organization running log)

(8) how well bottom plugged 2" PVC

DRILLERS REMARKS: Backwash


DEPT. OF NATURAL RESOURCES
BUREAU OF LAND & WATER RESOURCES

JAN 15 1981

RECEIVED

If well telescopes please sketch and show depths.

GROUND LEVEL

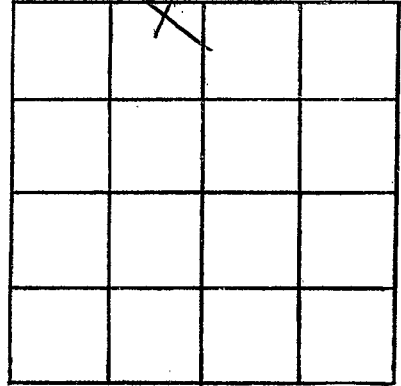

SECTION 28

Please indicate well location X.

ADDITIONAL INFORMATION

If more than one screen, show locations of each on sketch.