

MISSISSIPPI DEPARTMENT OF NATURAL RESOURCES

Bureau of Land and Water Resources

Southport Mall

P.O. Box 10631

Jackson, Mississippi 39209

WATER WELL DRILLERS LOG

CODED

Perry
OM 26
5-29-81

5-29- 1981 Fry-John well Service Perry
 date well completed firm name county well located

LANDOWNER: <u>Robert Lange</u>	description of formations encountered	from	to

(mailing address)

WELL LOCATION:
 sec. 4 T. 20 N. R. 9 E. S. 5 (W)
1/2 miles S of Baumont
 (distance) (direction) (nearest town)

WELL PURPOSE:
 home irrigation, municipal, industrial

WELL COMPLETION DATA: 5-29-81

- (1) diameter (inches) 2"
- (2) total depth (feet) 600'
- (3) static water level (feet) 20' below above top of ground.
- (4) casing PVC, 570'
 (material) (depth)
2"
 (size) if telescope see back.
- (5) screen 30', 570'
 (length) (depth to top)
2" PVC
 (size) (material)
- (6) pump NO, 3 7/2
 (HP) (yield gpm)
NO
 (type power)
- (7) electric log (yes or no)
- (organization running log)
- (8) how well bottom plugged 2" PVC
Backwash


<u>Top Soil</u>	<u>0</u>	<u>5</u>
<u>Sand</u>	<u>5</u>	<u>20</u>
<u>Red gravel</u>	<u>20</u>	<u>25</u>
<u>Blue Clay Sand</u>	<u>25</u>	<u>124</u>
<u>Sand</u>	<u>124</u>	<u>163</u>
<u>Blue Clay</u>	<u>163</u>	<u>455</u>
<u>fine sand</u>	<u>455</u>	<u>489</u>
<u>Blue Clay</u>	<u>489</u>	<u>535</u>
<u>fine sand</u>	<u>535</u>	<u>555</u>
<u>Med Sand</u>	<u>555</u>	<u>600</u>

DRILLERS REMARKS:

DEPT. OF NATURAL RESOURCES
 BUREAU OF LAND & WATER RESOURCES
 JUL 21 1981
RECEIVED

If well telescopes please
sketch and show depths.

GROUND LEVEL

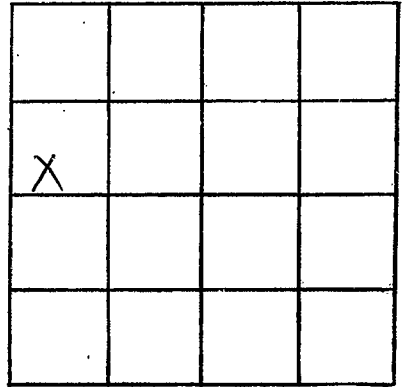

SECTION

8

Please indicate well location X.

ADDITIONAL INFORMATION

If more than one screen,
show locations of each on sketch.