

Perry  
M 27  
3-11-81

MISSISSIPPI  
BOARD OF WATER COMMISSIONERS  
416 North State Street  
Jackson, Mississippi 39201

**CODED**

WATER WELL DRILLERS LOG

3-11-81 date well completed  
1981 Fuffly Well Service firm name  
Perry county well located

LANDOWNER: Rabut Gause  
P.O. Box 377  
Beaumont, MS 39423  
(mailing address)

WELL LOCATION:  
sec. 4 T. 20 N. R. 9 E  
1 miles DE of Beaumont  
(distance) (direction) (nearest town)

WELL PURPOSE:  
(home irrigation, municipal, industrial)

WELL COMPLETION DATA: 3-12-81

- (1) diameter (inches) 2 1/2
- (2) total depth (feet) 480'
- (3) static water level (feet) 1' below top of ground.
- (4) casing PVC, 460' (material) (depth)  
2 1/2" (size) If telescope see back.
- (5) screen 20', 460' (length) (depth to top)  
2 1/2" PVC (size) (material)
- (6) pump 1 (HP) (yield gpm)  
E/F (type power)
- (7) electric log (yes or no)
- (organization running log)
- (8) how well bottom plugged 2 1/2" PVC  
Backwash


description of formations encountered	from	to
Top Soil	0	4
Sand	4	20
White Sand	20	30
gravel	30	35
Clay	35	35
Blue Clay	35	135
med. Sand	135	160
Blue Clay	160	245
Fine Sand	245	250
Blue Clay	250	455
Blue Sand	455	484
Bethun Fine & med. Butt Sharp		

**CODED**

DRILLERS REMARKS:

If well telescopes please sketch and show depths.

GROUND LEVEL

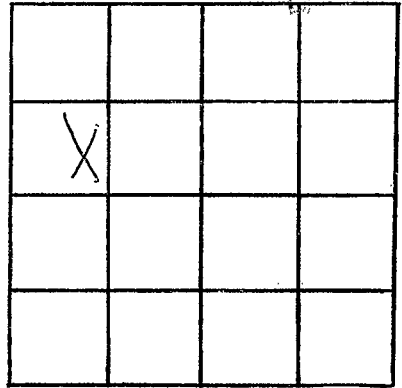

SECTION 8

Please indicate well location X.

ADDITIONAL INFORMATION

If more than one screen, show locations of each on sketch.

