

MISSISSIPPI DEPARTMENT OF NATURAL RESOURCES

Bureau of Land and Water Resources

Southport Mall

P.O. Box 10631

Jackson, Mississippi 39209

WATER WELL DRILLERS LOG

CODED

PERRY
M 29
9-85

9-1985 GRINER DRILLING CO. PERRY
date well completed firm name county well located

LANDOWNER: LITTLE CREEK
WATER ASSOC., McLain
Mississippi
(mailing address)

WELL LOCATION: SW 1/4 NW 1/4 NE 1/4
sec. 35 T 2 N R 9 E
S W

miles of (distance) (direction) of (nearest town)

WELL PURPOSE: RURAL W.A.
(home, irrigation, municipal, industrial)

WELL COMPLETION DATA:

- (1) diameter (inches) 8 5/8"
- (2) total depth (feet) 832 ft
- (3) static water level (feet) 130.96 below top of ground.
- (4) casing STEEL, 762, (material) (depth)
8 5/8" (size) if telescope see back.
- (5) screen 40 ft, 792 (length) (depth to top)
6" (size), 304 S.S. (.006") (material)
- (6) pump 20 (HP) 205 (yield gpm)
ELECT. (type power)
- (7) electric log Yes (yes or no)
MISS. GEOL. SURVEY (organization running log)
- (8) how well bottom plugged BACK
WITH VALVE & CEMENT PLUG

description of formations encountered	from	to
	TOP SOIL	0
CLAY + SAND streaks	3	35
SAND	35	68
CLAY	68	92
SAND	92	110
CLAY	110	192
SAND	192	280
CLAY	280	332
SAND	332	376
CLAY	376	400
SAND	400	508
CLAY	508	767
SAND	767	865
CLAY	865	1020

RECEIVED

OCT - 4 1985


Department of Natural Resources
Bureau of Land & Water Resources

N R

DRILLERS REMARKS:

If well telescopes please sketch and show depths.

GROUND LEVEL

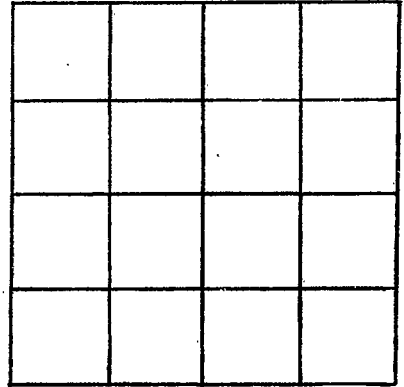

SECTION _____

Please indicate well location X.

ADDITIONAL INFORMATION

If more than one screen, show locations of each on sketch.