

Perry
M 200
10-8-76

MISSISSIPPI
 BOARD OF WATER COMMISSIONERS
 416 North State Street
 Jackson, Mississippi 39201

WATER WELL DRILLERS LOG

Oct 8 1976 Cash and Drilling Inc. Perry
 date well completed firm name county well located

LANDOWNER: James Covant
Rt 3 McClaine
 (mailing address)

description of formations encountered	from	to
<u>top soil</u>	<u>0</u>	<u>2</u>
<u>Brown clay</u>	<u>2</u>	<u>11</u>
<u>red clay</u>	<u>11</u>	<u>23</u>
<u>gray clay</u>	<u>23</u>	<u>60</u>
<u>Sand</u>	<u>60</u>	<u>85</u>

WELL LOCATION:
 sec. 22 T 5 N R 9 E
4 miles W of Little Creek
 (distance) (direction) (nearest town)

WELL PURPOSE: home
 (home, irrigation, municipal, industrial)

- WELL COMPLETION DATA:
- (1) diameter (inches) 2"
 - (2) total depth (feet) 85'
 - (3) static water level (feet) 51 ^{below} top of ground.
 - (4) casing PVC, 80'
 (material) (depth)
 If telescope see back.
 (size)
 - (5) screen 5', 80'
 (length) (depth to top)
2" PVC
 (size) (material)
 - (6) pump 1 6
 (HP) (yield gpm)
elect
 (type power)
 - (7) electric log no
 (yes or no)
 (organization running log)
 - (8) how well bottom plugged value

RECEIVED


DEC 3 1976

DRILLERS REMARKS:

MISSISSIPPI WATER COMMISSION

If well telescopes please sketch and show depths.

GROUND LEVEL

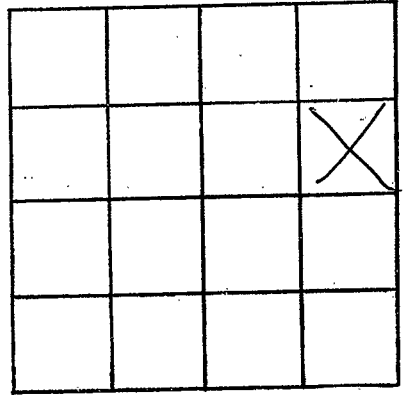

SECTION 22

Please indicate well location X.

ADDITIONAL INFORMATION

Lined area for additional information.

If more than one screen, show locations of each on sketch.