

Perry
 M 2002
 6-7-77

MISSISSIPPI
 BOARD OF WATER COMMISSIONERS. P. CLARK
 416 North State Street WATER WELL DRILLING
 Jackson, Mississippi 39201 ROUTE 2
 LAUREL, MISS. 39440
 WATER WELL DRILLERS LOG

6/7 1977 date well completed
 C. P. Clark firm name
 Perry county well located

LANDOWNER: Mary Weakle
 Rt#1 Box 47
 Beaumont Miss 39423
 (mailing address)

WELL LOCATION:
 sec. 9 T. 20 N. R. 9 E. W. 1
 1 miles S of Beaumont
 (distance) (direction) (nearest town)

WELL PURPOSE: Cistern
 (home, irrigation, municipal, industrial)

- WELL COMPLETION DATA:
- (1) diameter (inches) 2
 - (2) total depth (feet) 263
 - (3) static water level (feet) 15 below top of ground.
 - (4) casing Galvneon 253 (material) (depth)
 - (5) screen 10 ft 253 (length) (depth to top)
 1 1/4 S.S. 006 (size) (material)
 - (6) pump 1 15 (HP) (yield gpm)
 220V S.P. (type power)
 - (7) electric log No (yes or no)
 - (8) how well bottom plugged B W U

description of formations encountered	from	to
Sandy Clay	0	5
Sand	5	20
Clay	20	30
Clay & Sand Streaks	50	89
Clay (Green)	89	150
Coarse Sand	150	190
Clay	190	210
Sand & fine gravel	210	265
Still in sand & gravel (a) 265		


RECEIVED
 JUN 15 1977

DRILLERS REMARKS: Set 12 A
 Set 42 ft, used Cistern
 Leads pump & tank

MISS. BD. OF WATER COMMISSIONERS

If well telescopes please sketch and show depths.

GROUND LEVEL

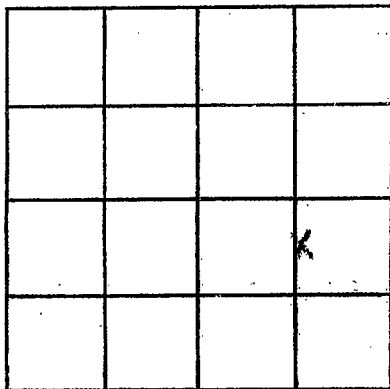

SECTION 9

Please indicate well location X.

ADDITIONAL INFORMATION

If more than one screen, show locations of each on sketch.