

PERRY
 M 2003
 12-01-78

MISSISSIPPI
 BOARD OF WATER COMMISSIONERS
 416 North State Street
 Jackson, Mississippi 39201

WATER WELL DRILLERS LOG

Dec 1 1978 Bob's Drilling & Log Perry
 date well completed firm name county well located

LANDOWNER: Don W. Moody
Box 1 Beaumont Miss

description of formations encountered	from	to
Clay	0	19
fine sand	19	60
hard sand	60	81
shale in sand		
when stopped drilling		
52' 1" P.V.C. drop pipe		

(mailing address)
 WELL LOCATION:
 sec. 22 T. 23 N. R. 9 E
3 miles SE of Beaumont
 (distance) (direction) (nearest town)

WELL PURPOSE: home
 (home, irrigation, municipal, industrial)

- WELL COMPLETION DATA:
- (1) diameter (inches) 2"
 - (2) total depth (feet) 81
 - (3) static water level (feet) 36 ^{below} _{above} top of ground.
 - (4) casing PVC 76'
 (material) (depth)
2" if telescope see back.
 (size)
 - (5) screen 5' 76
 (length) (depth to top)
2" 2 slot P.V.C.
 (size) (material)
 - (6) pump 1 15
 (HP) (yield gpm)
elec.
 (type power)
 - (7) electric log no
 (yes or no)
- (organization running log)

(8) how well bottom plugged
1/4" back wash valve

DRILLERS REMARKS:


Miss. Board of Water Comm.

8
 FEB 8 1979

RECEIVED

If well telescopes please sketch and show depths.

GROUND LEVEL

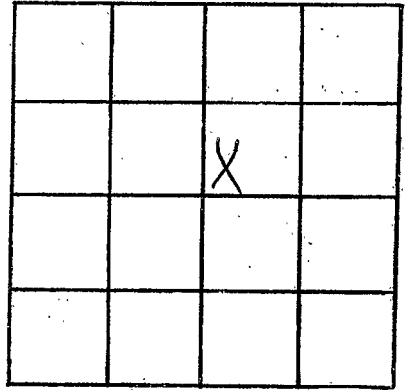

SECTION 22

Please indicate well location X.

ADDITIONAL INFORMATION

If more than one screen,
show locations of each on sketch.