

PERRY
 M 2004
 7-12-78

MISSISSIPPI
 BOARD OF WATER COMMISSIONERS
 416 North State Street
 Jackson, Mississippi 39201

WATER WELL DRILLERS LOG

7/13/78 C.A. Clark Perry
 date well completed firm name county well located

LANDOWNER: George Belmore

description of formations encountered	from	to
Clay	0	12
Blue sand	12	18
Blue Clay	18	35
Sand & Gravel	35	84
Green Clay	84	171
Sand & Gravel	171	230

Boat 392
 Beaumont Miss.
 (mailing address)

WELL LOCATION:
 sec. 10 T. 2 N. R. 9 E. S. 1 W.
 1 1/2 miles S.E. of Beaumont
 (distance) (direction) (nearest town)

WELL PURPOSE: Home
 (home, irrigation, municipal, industrial)

WELL COMPLETION DATA:


- (1) diameter (inches) 2
- (2) total depth (feet) 230
- (3) static water level (feet) below below top of ground.
- (4) casing Galvneon 210' (material) (depth)
- (size) if telescope see back.
- (5) screen 10, 210 (length) (depth to top)
 1/4" Solid S.S. 006 (size) (material)
- (6) pump None 6 G.P.M. (HP) (yield gpm)
 None (type power)
- (7) electric log no (yes or no)
 (organization running log)
- (8) how well bottom plugged Boiled

DRILLERS REMARKS:

RECEIVED
 OCT 4 1978

If well telescopes please sketch and show depths.

GROUND LEVEL

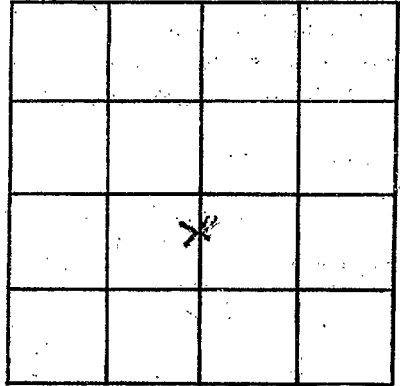

SECTION 10

Please indicate well location X.

ADDITIONAL INFORMATION

If more than one screen, show locations of each on sketch.