

PERRY  
 M 2005  
 2-21-79

MISSISSIPPI  
 BOARD OF WATER COMMISSIONERS  
 416 North State Street  
 Jackson, Mississippi 39201

WATER WELL DRILLERS LOG

Sub 21 1979 Port. Drillers Perry  
 date well completed firm name county well located

LANDOWNER: J. S. Hartfield

description of formations encountered from to

Box 64  
Beaumont, Miss  
 (mailing address)

clay	0	18
fine sand & clay	18	30
fine sand	30	25
hard some finer gravel	85	93
stop at white shell in sand		

WELL LOCATION:  
 sec. 22 T. 2 N. R. 9 E. S. 1 W.  
3 miles SE of Beaumont  
 (distance) (direction) (nearest town)

WELL PURPOSE: line  
 (home, irrigation, municipal, industrial)

52" 1" P.V.C. drop pipe

- WELL COMPLETION DATA:
- (1) diameter (inches) 2"
  - (2) total depth (feet) 93'
  - (3) static water level (feet) 21' (below/above top of ground)
  - (4) casing PVC 88'  
 (material) (depth)  
2" if telescope see back.  
 (size)
  - (5) screen 5' 88'  
 (length) (depth to top)  
2" solid P.V.C.  
 (size) (material)
  - (6) pump 1 15  
 (HP) (yield gpm)  
elec  
 (type power)
  - (7) electric log no  
 (yes or no)

Miss. Board of Water Comm.


MAR 19 1979

DRILLERS REMARKS:

RECEIVED

If well telescopes please sketch and show depths.

GROUND LEVEL

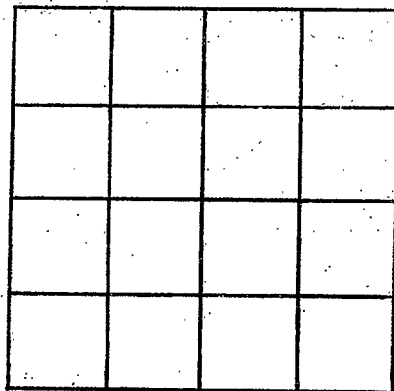

SECTION 22

Please indicate well location X.

ADDITIONAL INFORMATION

If more than one screen,  
show locations of each on sketch.