

Perry  
 M 2007  
 6-7-81

MISSISSIPPI  
 BOARD OF WATER COMMISSIONERS  
 416 North State Street  
 Jackson, Mississippi 39201

WATER WELL DRILLERS LOG

June 4 1981 Cochran Brothers Drilling Perry  
 date well completed firm name county well located

LANDOWNER:  
 Ed S. HARRING  
 Rt 1 Beaumont  
 (mailing address)

description of formations encountered	from	to
Top Soil	0	2
Brown clay	2	6
Sand + gravel	6	28
Blue clay	28	53
Sand	53	70

WELL LOCATION:  
 sec. 9 T 20 N R 9 E  
 S W  
 3 miles S of Beaumont  
 (distance) (direction) (nearest town)

WELL PURPOSE: home  
 (home, irrigation, municipal, industrial)

- WELL COMPLETION DATA:
- diameter (inches) 2"
  - total depth (feet) 71
  - static water level (feet) 19' below top of ground.
  - casing PVC, 60' (material), (depth)  
 2" (size) if telescope see back.
  - screen 10', 60' (length), (depth to top)  
 2" (size), PVC (material)
  - pump (HP) (yield gpm)  
 (type power)
  - electric log (yes or no)  
 (organization running log)
  - how well bottom plugged valve

DRILLERS REMARKS:


DEPT. OF NATURAL RESOURCES  
 BUREAU OF LAND & WATER RESOURCES

JUL 22 1981

RECEIVED

If well telescopes please sketch and show depths.

GROUND LEVEL

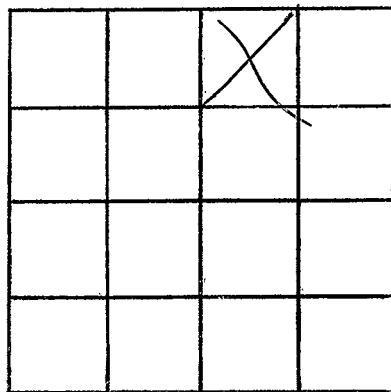

SECTION 9

Please indicate well location X.

ADDITIONAL INFORMATION

If more than one screen, show locations of each on sketch.