

MISSISSIPPI DEPARTMENT OF NATURAL RESOURCES

Bureau of Land and Water Resources

Southport Mall

P.O. Box 10631

Jackson, Mississippi 39209

WATER WELL DRILLERS LOG

Perry
M 2008
6-12-81

6-12- 1981 Engr Well Service Perry
 date well completed firm name county well located

LANDOWNER: David Fairly

description of formations encountered	from	to
<u>top sand</u>	<u>0</u>	<u>5</u>
<u>clay</u>	<u>5</u>	<u>10</u>
<u>sand</u>	<u>10</u>	<u>30</u>
<u>clay</u>	<u>30</u>	<u>70</u>
<u>blue clay</u>	<u>70</u>	<u>110</u>
<u>fine sand</u>	<u>110</u>	<u>130</u>
<u>med sand</u>	<u>130</u>	<u>150</u>

(mailing address)

WELL LOCATION:
23 sec 4 T 2 N R 9 E W
8 miles E of Beant
 (distance) (direction) (nearest town)

WELL PURPOSE:
home irrigation, municipal, industrial

WELL COMPLETION DATA:

- (1) diameter (inches) 2"
- (2) total depth (feet) 150'
- (3) static water level (feet) 95' below above top of ground.
- (4) casing PVC 140'
 (material) (depth)
2"
 (size) if telescope see back.
- (5) screen 10' 140'
 (length) (depth to top)
2" PVC
 (size) (material)
- (6) pump 2 7
 (HP) (yield gpm)
E/E
 (type power)
- (7) electric log (yes or no)
 (organization running log)
- (8) how well bottom plugged 2" PVC
Backwash


DRILLERS REMARKS: poor

DEPT. OF NATURAL RESOURCES
 BUREAU OF LAND & WATER RESOURCES

JUL 21 1981
 RECEIVED

If well telescopes please sketch and show depths.

GROUND LEVEL

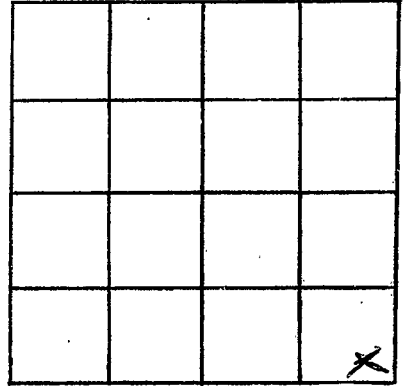

SECTION 23

Please indicate well location X.

ADDITIONAL INFORMATION

If more than one screen,
show locations of each on sketch.