

MISSISSIPPI DEPARTMENT OF NATURAL RESOURCES
 Bureau of Land and Water Resources
 Southport Mall
 P.O. Box 10631
 Jackson, Mississippi 39209
WATER WELL DRILLERS LOG

This well is within mile Beaumont

Perry
M 2009
8-1-81

8-1-1981 date well completed
 81 Farfogle well Swimp Perry firm name
 county well located

LANDOWNER: Milton HART Field
Rt 1, Beaumont, Miss.
 (mailing address)

description of formations encountered	from	to
top soil	0	5
clay	5	30
white hard clay	30	70
blue clay	70	110
Brown sand	110	130
Brown & white sand	130	150


WELL LOCATION:
 sec. 20 T. 2 N. R. 9 E. S. W
8 miles E of Beaumont
 (distance) (direction) (nearest town)

WELL PURPOSE:
 home, irrigation, municipal, industrial

WELL COMPLETION DATA: 8-1-81

- (1) diameter (inches) 2"
- (2) total depth (feet) 150'
- (3) static water level (feet) 103' below top of ground.
- (4) casing PVC, 140'
 (material) (depth)
2"
 (size) if telescope see back.
- (5) screen 10', 140'
 (length) (depth to top)
2", PVC
 (size) (material)
- (6) pump 2, 6
 (HP) (yield gpm)
ET
 (type power)
- (7) electric log (yes or no) no
 (organization running log)
- (8) how well bottom plugged 2" clay
marks


DRILLERS REMARKS:

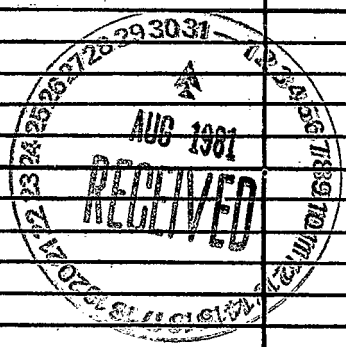

[Handwritten initials]

If well telescopes please
sketch and show depths.

GROUND LEVEL

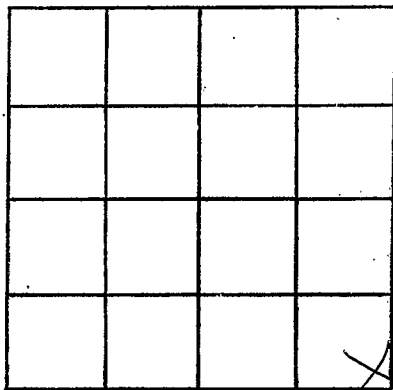

SECTION 23

Please indicate well location X.

ADDITIONAL INFORMATION



If more than one screen,
show locations of each on sketch.