

MISSISSIPPI DEPARTMENT OF NATURAL RESOURCES
Bureau of Land and Water Resources
 Southport Mall
 P.O. Box 10631
 Jackson, Mississippi 39209
WATER WELL DRILLERS LOG

Perry
M
2011

8-30 1982 Fry Fork well @ Perry
 date well completed firm name county well located

LANDOWNER: *MARY DORTCH*
FHA
Beaumont ms
 (mailing address)

description of formations encountered	from	to
<i>top soil</i>	<i>0</i>	<i>5</i>
<i>V Clay</i>	<i>5</i>	<i>20</i>
<i>Shaly Sand & Clay</i>	<i>20</i>	<i>30</i>
<i>Clay</i>	<i>30</i>	<i>40</i>
<i>Sand</i>	<i>40</i>	<i>46</i>

WELL LOCATION:
15 miles *3E* of *Beaumont*
 (distance) (direction) (nearest town)

WELL PURPOSE:
 (home, irrigation, municipal, industrial)

- WELL COMPLETION DATA:
- (1) diameter (inches) 2
 - (2) total depth (feet) 46
 - (3) static water level (feet) 35' below above top of ground.
 - (4) casing PVC, 36
 (material) (depth)
 (size) If telescope see back.
 - (5) screen 10', 36
 (length) (depth to top)
2", PVC
 (size) (material)
 - (6) pump 1, 5
 (HP) (yield gpm)
Electrol
 (type power)
 - (7) electric log no
 (yes or no)
- (organization running log)


(8) how well bottom plugged PVC
Beaumont

DEPT. OF NATURAL RESOURCES
 BUREAU OF LAND & WATER RESOURCES

NOV - 8 1982

RECEIVED

DRILLERS REMARKS:

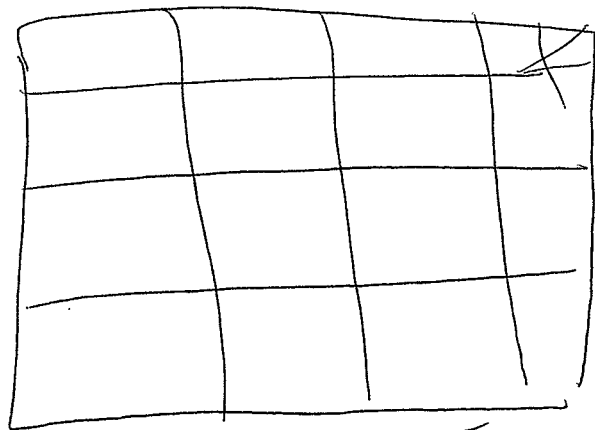

Sect. 15

GEORGE

1909