

MISSISSIPPI DEPARTMENT OF NATURAL RESOURCES

Bureau of Land and Water Resources

Southport Mall

P.O. Box 10631

Jackson, Mississippi 39209

WATER WELL DRILLERS LOG

Perry
M
2012

9-25
date well completed

1982 Fry Fogle Well Co.
firm name

Perry
county well located

LANDOWNER: Arnold Miniald
RT-1
Bremen, MS. 39423
(mailing address)

description of formations encountered	from	to
Top Soil + clay	0	10
Plm	10	14
clay	14	24

WELL LOCATION:
sec. 18 T 2 N R 9 E
S W
2 miles SE of Bremen
(distance) (direction) (nearest town)


WELL PURPOSE:
(home, irrigation, municipal, industrial)

- WELL COMPLETION DATA:
- (1) diameter (inches) 2
 - (2) total depth (feet) 20'
 - (3) static water level (feet) 12 below above top of ground.
 - (4) casing PVC 21'
(material) (depth)
(size) If telescope see back.
 - (5) screen 3 21'
(length) (depth to top)
1/4" PVC
(size) (material)
 - (6) pump Hand 5
(HP) (yield gpm)
Pitcher Pump
(type power)
 - (7) electric log W
(yes or no)
(organization running log)
 - (8) how well bottom plugged Plug

DRILLERS REMARKS:

DEPT. OF NATURAL RESOURCES
BUREAU OF LAND & WATER RESOURCES

NOV 15 1982
RECEIVED

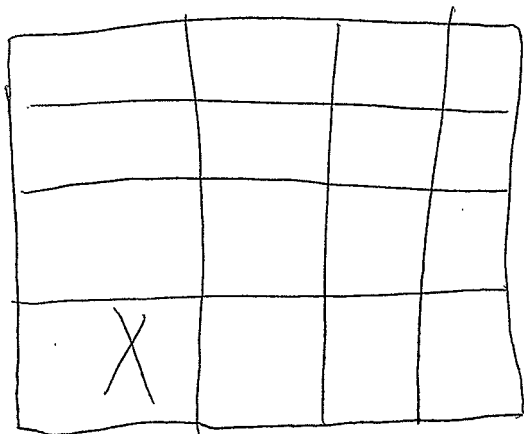

Section 10