

MISSISSIPPI DEPARTMENT OF NATURAL RESOURCES

Bureau of Land and Water Resources

Southport Mall

P.O. Box 10631

Jackson, Mississippi 39209

WATER WELL DRILLERS LOG

*Perry*  
M  
2013

3/18/1982 Frydolph water well Perry  
date well completed firm name county well located

LANDOWNER: D.M. Lister  
P.O. Box 68  
McLain, MS 39456  
(mailing address)

WELL LOCATION:  
sec. 4 T 10 N R 9 E  
5.3 miles W of McLain, MS  
(distance) (direction) (nearest town)

WELL PURPOSE:  
(home, irrigation, municipal, industrial)

WELL COMPLETION DATA:  
(1) diameter (inches) 4"  
(2) total depth (feet) 197'  
(3) static water level (feet) 90 (below top of ground)  
(4) casing PVC 187' (material) (depth)  
no (size) if telescope see back.  
(5) screen 10' 187' (length) (depth to top)  
4" P.V.C. gravel pack (size) (material)  
(6) pump 1 (HP) 15 (yield gal)  
Elet. Sub. (type power)  
(7) electric log no (yes or no)  
no (organization running log)

(8) how well bottom plugged PVC, Ball Check

description of formations encountered	from	to
Red Clay	0	20
Brown Clay	20	40
Sandy Clay	40	60
Blue Clay	60	80
Sandy Clay	80	100
Blue Clay	100	120
Fine Sand (w/ clay)	120	140
Dark Brown sand Slightly	140	160
Med Br. Med. Sand	160	180
Light Br. Coars. Sand	180	197

DRILLERS REMARKS: Extra good well could handle 30 to 50 gal P.M. Pump


DEPT. OF NATURAL RESOURCES  
BUREAU OF LAND & WATER RESOURCES

APR 6 1982

RECEIVED

If well telescopes please sketch and show depths.

GROUND LEVEL

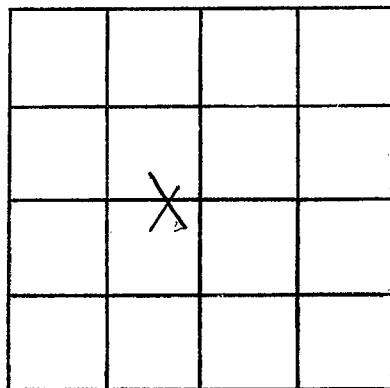

SECTION 4

Please indicate well location X.

ADDITIONAL INFORMATION

If more than one screen, show locations of each on sketch.