

MISSISSIPPI DEPARTMENT OF NATURAL RESOURCES

Bureau of Land and Water Resources

Southport Mall

P.O. Box 10631

Jackson, Mississippi 39209

WATER WELL DRILLERS LOG

Perry
M
2014

10-19
date well completed

82 Frank Price
firm name

Perry
county well located

LANDOWNER:	description of formations encountered	from	to
<i>J. R. Moore</i>	<i>Top Soil</i>	<i>0</i>	<i>3</i>
(mailing address)	<i>Sandy clay</i>	<i>3</i>	<i>25</i>
WELL LOCATION:	<i>Course Sand</i>	<i>25</i>	<i>34</i>
sec. <i>17</i> T. <i>2</i> N. R. <i>9</i> E. S. <i>5</i> W.			
<i>2 1/2</i> miles S of <i>Beaumont</i>			
(distance) (direction) (nearest town)			
WELL PURPOSE: <i>HOME</i>			
(home, irrigation, municipal, industrial)			
WELL COMPLETION DATA:			
(1) diameter (inches) <i>2"</i>			
(2) total depth (feet) <i>34'</i>			
(3) static water level (feet) <i>18'</i> below top of ground.			
(4) casing <i>Plastic</i> , <i>29'</i>			
(material) (depth)			
(size) if telescope see back.			
(5) screen <i>3'</i> , <i>29'</i>			
(length) (depth to top)			
<i>2"</i> , <i>Plastic</i>			
(size) (material)			
(6) pump <i>1</i> , <i>8</i>			
(HP) (yield gpm)			
<i>Elect</i>			
(type power)			
(7) electric log <i>no</i>			
(yes or no)			
(organization running log)			
(8) how well bottom plugged <i>Capped</i>			
DRILLERS REMARKS:			


DEPT. OF NATURAL RESOURCES
BUREAU OF LAND & WATER RESOURCES

NOV - 4 1982

RECEIVED

If well telescopes please sketch and show depths.

GROUND LEVEL

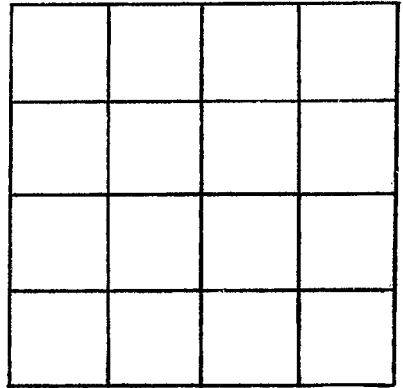

SECTION _____

Please indicate well location X.

ADDITIONAL INFORMATION

If more than one screen,
show locations of each on sketch.