

# MISSISSIPPI DEPARTMENT OF NATURAL RESOURCES

Bureau of Land and Water Resources

P.O. Box 10631

Jackson, Mississippi 39209

WATER WELL DRILLERS LOG

COUNTY WELL LOCATED <b>Perry</b>	
WELL NUMBER <b>M</b>	CODED
DATE WELL COMPLETED <b>2015 7-22-87</b>	

PERMIT NUMBER
NAME OF DRILLING FIRM <b>Pierce Drilling Co.</b>

NAME & MAILING ADDRESS OF LANDOWNER <b>Mathel Hinton</b>		
<b>Lake Perry</b>		
<b>Beaumont Ms</b>		
WELL LOCATION: SEC	TOWNSHIP	RANGE
<b>16</b>	<b>2</b>	<b>9</b>
DISTANCE	DIRECTION	NEAREST TOWN
<b>6</b> Miles	<b>West</b> of	<b>Beaumont</b>
OTHER LANDMARK		
WELL PURPOSE <input checked="" type="radio"/> Home Irrigation, Municipal, Industrial, Fish Pond, etc.		

<b>PUMP DATA</b>		
PUMP TYPE (Circle One): Submersible, Turbine, <input checked="" type="radio"/> Jet, Flowing Well, Other (Describe) _____		
POWER TYPE (Circle One): <input checked="" type="radio"/> Electric, Tractor, Diesel, Gasoline, Butane, Other (Describe) _____		
Pump Capacity (GPM) <b>10</b>	No. of Stages <b>3</b>	Setting Depth <b>60</b> FT.
PUMP TEST		
Well yielded <b>10</b> GPM with a drawdown of <b>10</b> ft. after <b>1</b> hours of pumping		

<b>WELL DATA</b>		
Well Depth <b>160</b>	Casing Diameter (In.) <b>2</b>	Casing Length (Ft.) <b>150</b>
Type of Casing <b>Plastic</b>	Hole Depth <b>160</b>	Depth to Static Water Level <b>60'</b>
TYPE OF COMPLETION: (Circle One or More): Gravel-Packed, Underreamed, Telescoped, Natural Development, <input checked="" type="radio"/> Open Hole, Other (Describe) _____		
Top of Lap Pipe or Reduction in Casing		
<b>FEET</b>	IF TELESCOPED OR MORE THAN ONE SCREEN: USE BACK PAGE	

<b>LOG DATA</b>	
TYPE OF LOG RUN (Circle One): Electric, Gamma Ray, Density, Sonic, Neutron, Other (Describe) _____	
<input checked="" type="radio"/> No Log Run	
Name of Organization Running Log	

<b>SCREEN DATA</b>		
Diameter - Inches <b>2"</b>	Length - Feet <b>10</b>	Slot Size - Inches <b>006</b>
Screen Type <b>Plastic</b>		Depth to Bottom - Feet <b>160'</b>

<b>GEOLOGIC DATA (Office Use Only)</b>			
Surface Elev.	Geologic Unit	Unit Thickness	Depth to Top
Subs. SWL	Date	Analysis	Aquifer Test

Driller's Remarks
-------------------


RECEIVED

DESCRIPTION OF FORMATIONS ENCOUNTERED	FROM	TO	FORMATIONS (Continued)
<b>Top Soil</b>	<b>0</b>	<b>10</b>	<div style="font-size: 2em; font-weight: bold; opacity: 0.5;">RECEIVED</div> <p style="font-size: 1.5em; font-weight: bold;">SEP 15 1987</p> <p style="font-weight: bold;">Department of Natural Resources Bureau of Land &amp; Water Resources</p>
<b>Clay</b>	<b>10</b>	<b>30</b>	
<b>good Sand</b>	<b>30</b>	<b>40</b>	
<b>Clay</b>	<b>40</b>	<b>130</b>	
<b>good Sand</b>	<b>130</b>	<b>160</b>	

IF MORE SPACE IS NEEDED, USE BACK

If well telescopes please  
sketch and show depths.

GROUND LEVEL

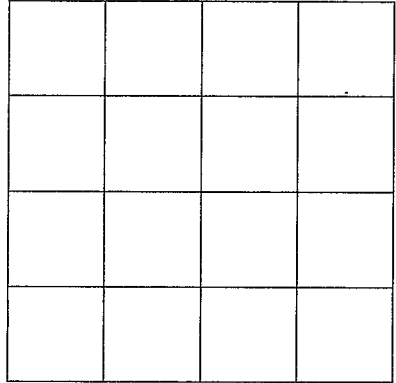

SECTION \_\_\_\_\_

Please indicate well location X.

ADDITIONAL INFORMATION

If more than one screen,  
show location of each on sketch.