

MISSISSIPPI BOARD OF WATER COMMISSIONERS

~~FERRY~~
PERRY
N4
11-13-60

WATER WELL DRILLERS LOG

(7)
~~11-13-60~~

Date: 11-13, 1960, Driller: Duck & Eric County PR
(Name)

(1) Owner of Land: J. V. Martin
(Name)
Brocklyn Miss.
(Address)

(2) Location: 1/4, 1/4, Sec. 9 T R
5 miles east, Brocklyn
(distance) (direction) (Nearest Town)

(3) Topography: X
(Hilly) (Flat) (Level)

(4) Purpose of Well: Chickens
(Domestic Irrigation
Municipal, Industrial, Other)

Description & Color of Materials Sand, Clay, Red Clay, Shell, etc.	Thick- ness Feet	Depth Feet
<u>Surface Sand.</u>	<u>0</u>	<u>60</u>
<u>white clay.</u>	<u>60</u>	<u>70</u>
<u>good sand</u>	<u>70</u>	<u>106</u>

Information upon completion of well:

(1) Diameter 4" inches.

(2) Total Depth 106 feet.


(3) Water Level 106 feet below top of ground.

(4) Cased to _____, Size _____

(5) Screen: Size 4", Length 10'

(6) Were any formations sealed against pollution?
_____ yes, X no.

106

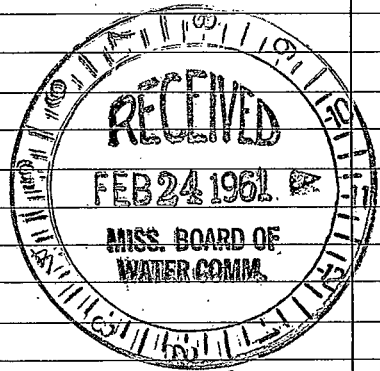

If YES depth of formation _____

Why _____

Drillers Remarks: good well
Pumped 20 gal Per.
WL - 60 feet.
Submers. pump Some rust

3
X

(Use Back Side)

Well No.

1870
1871
1872
1900